

WALTHALL

J

6-21-66 MISSISSIPPI BOARD OF WATER COMMISSIONERS

J13

WATER WELL DRILLERS LOG

Walthall

Date: 6-21, 1966, Driller: Jim Fitzgerald County Walthall  
(When well drilled) (Name) (Where well is located)

(1) Owner of Land: Willie Ball  
(Name)

(Address)

(2) Location: SE 1/4, S 1/4, Sec. 15 T#R  
1-11

12 miles SE of Tehitown  
(distance) (direction) (Nearest Town)

(3) Topography: X  
(Hilly) (Flat) (Level)

(4) Purpose of Well: Domestic  
(Domestic Irrigation  
Municipal, Industrial, Other)

Description & Color of Materials Sand, Clay, Red Clay, Shell, etc.	Thick- ness Feet	Depth Feet
<u>Topsoil &amp; clay</u>	<u>8</u>	<u>15</u>
<u>gravel</u>	<u>15</u>	<u>40</u>
<u>gravel + red sand</u>	<u>40</u>	<u>75</u>
<u>litter sand</u>	<u>75</u>	<u>110</u>
<u>gravel + coarse sand</u>	<u>110</u>	<u>118</u>
<u>white clay</u>	<u>118</u>	<u>120</u>

Information upon completion of well:

(1) Diameter 4 inches.

(2) Total Depth 116 feet.

(3) Water Level 80 feet below top of ground.

(4) Cased to 116, Size 8 1/2"

(5) Screen: Size 4", Length 8'

(6) Were any formations sealed against pollution?  
 \_\_\_\_\_ yes, X no.

If YES depth of formation \_\_\_\_\_


Why \_\_\_\_\_

Drillers Remarks:

Yield in gpm: 15 gpm

Size pump: 1 HP Jet

Type power: electric

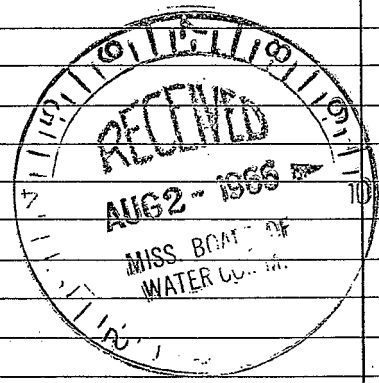

Mail this copy to Board of Water Commissioners 429 Miss. St. Jackson, Miss.

