

Walthall

MISSISSIPPI BOARD OF WATER COMMISSIONERS

T14

10-66

WATER WELL DRILLERS LOG

Date: 10/13, 1966, Driller: T. B. Andrews County Walthall (Name)

(1) Owner of Land: Teddis Conaway
(Name)
Rt. 7 Tybertown, Miss.
(Address)

(2) Location: NE 1/4, NE 1/4, Sec. 30 T1 R11,
8 1/2 miles S. E. of Tybertown,
(distance) (direction) (Nearest Town)

(3) Topography: Hilly
(Hilly) (Flat) (Level)

(4) Purpose of Well: Domestic
(Domestic Irrigation
Municipal, Industrial, Other)

Description & Color of Materials Sand, Clay, Red Clay, Shell, etc.	Thick- ness Feet	Depth Feet
<u>Red Clay</u>	<u>50'</u>	<u>50'</u>
<u>Sand / gravel</u>	<u>20'</u>	<u>70'</u>
<u>Chalk</u>	<u>30'</u>	<u>100'</u>
<u>Sand / gravel</u>	<u>28'</u>	<u>128'</u>

Information upon completion of well:

(1) Diameter 4 inches.

(2) Total Depth 128' feet.

(3) Water Level 100 feet below top of ground.

(4) Cased to 128', Size 4"

(5) Screen: Size 4", Length 6"


(6) Were any formations sealed against pollution?
 yes, no.

If YES depth of formation _____

Why _____

Drillers Remarks: Plastic Well

CODED

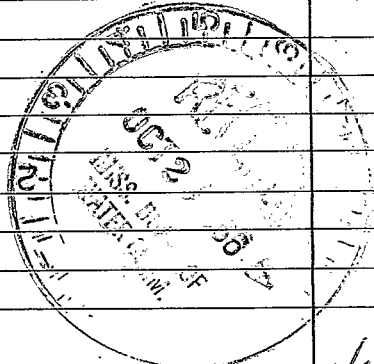

(Use Back Side)

43

Well No.

