

Walthall

T 15

12-66

COPY

MISSISSIPPI
 BOARD OF WATER COMMISSIONERS
 416 North State Street
 Jackson, Mississippi 39201

WATER WELL DRILLERS LOG

12-27

66 Fitzgerald Water Well Sup. Walthall

date well completed

firm name

county well located

LANDOWNER: Bird Martin
R7 Tylertown, Miss

description of formations encountered	from	to
Top soil clay	0	15
Red sand	60	75
Medium coarse sand	85	80
White chalk	28	108
Progressively coarser sand	127	135
White chalk	135	

(mailing address)

WELL LOCATION:

sec. 4 T 1 N 11 E
 S W
9 miles SE of Tylertown
 (distance) (direction) (nearest town)


WELL PURPOSE: home
 (home, irrigation, municipal, industrial)

WELL COMPLETION DATA:

- (1) diameter (inches) 4
- (2) total depth (feet) 134
- (3) static water level (feet) 60 below above top of ground.
- (4) casing plastic, 126
 (material) (depth)
- 4 if telescope see back.
 (size)
- (5) screen 8', 126
 (length) (depth to top)
4", plastic
 (size) (material)
- (6) pump 1/2 hp, 9
 (HP) (yield gpm)
elec
 (type power)
- (7) electric log No
 (yes or no)
 (organization running log)
- (8) how well bottom plugged Wood Peg


COPY

DRILLERS REMARKS:

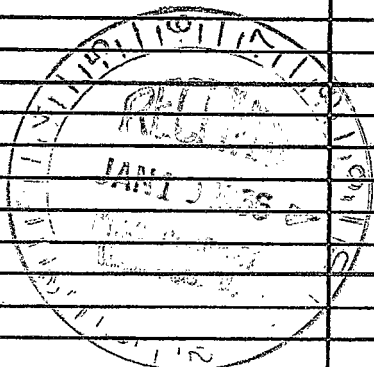

If well telescopes please sketch and show depths.

GROUND LEVEL

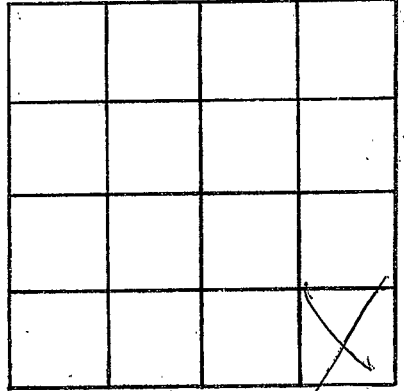

SECTION 4

Please indicate well location X.

ADDITIONAL INFORMATION

If more than one screen,
show locations of each on sketch.