

Waithall
 J16
 7-67

MISSISSIPPI
 BOARD OF WATER COMMISSIONERS
 416 North State Street
 Jackson, Mississippi 39201

CODED

WATER WELL DRILLERS LOG

7/1/67 19 Andie Drilling Co. Waithall
 date well completed firm name county well located

LANDOWNER: R.O. Sanfer
 ct. 7 Lybectown
 Miss.
 (mailing address)


description of formations encountered	from	to
Red Clay	0'	20'
Sand/Clay	20'	40'
Chalk	40'	68'
Sand/gravel	68'	80'

WELL LOCATION:
 sec. 25 T 1 N R 11 E
 S W
 7 1/2 miles SE of Lybectown
 (distance) (direction) (nearest town)

WELL PURPOSE: Home
 (home, irrigation, municipal, industrial)

- WELL COMPLETION DATA:
- (1) diameter (inches) 4"
- (2) total depth (feet) 80'
- (3) static water level (feet) 13' below top of ground
- (4) casing P.V.C. 74' (material) (depth)
 4" (size) if telescope see back.
- (5) screen 6' 80' (length) (depth to top)
 4" P.V.C. (size) (material)
- (6) pump 3/4 Jet 6 (HP) (yield gpm)
 220 (type power)
- (7) electric log No (yes or no)
 (organization running log)
- (8) how well bottom plugged Back Wash Valve


CODED

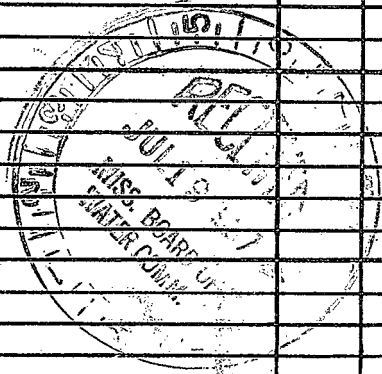

DRILLERS REMARKS:

If well telescopes please sketch and show depths.

GROUND LEVEL

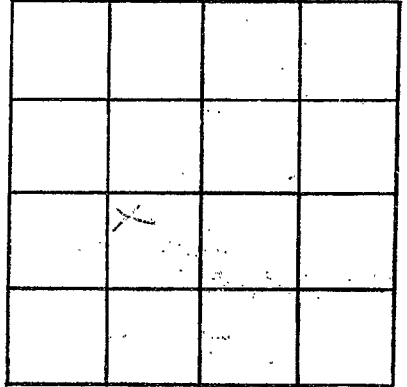

SECTION 25

Please indicate well location X.

ADDITIONAL INFORMATION

If more than one screen, show locations of each on sketch.