

**MISSISSIPPI
BOARD OF WATER COMMISSIONERS**
416 North State Street
Jackson, Mississippi 39201

CODED WATER WELL DRILLERS LOG

Walsh
J17
9-67

Sept 11 1967 Fitzgerald Walsh
date well completed firm name county well located

LANDOWNER: Johnny Magee

description of formations encountered	depth	
	from	to

Residential Fulton, Miss
(mailing address)

<u>Red clay</u>	<u>0</u>	<u>20</u>
<u>Crane sand</u>	<u>20</u>	<u>45</u>
<u>Red shaly sand</u>	<u>45</u>	<u>80</u>
<u>Crane shaly sand</u>	<u>80</u>	<u>100</u>


WELL LOCATION:
sec. 15 T 1 N R 11 E
6 miles SE of Fulton
(distance) (direction) (nearest town)

WELL PURPOSE: Home
(home, irrigation, municipal, industrial)

WELL COMPLETION DATA:

- (1) diameter (inches) 4
- (2) total depth (feet) 102
- (3) static water level (feet) 30 below above top of ground.
- (4) casing Plastic 96'
(material) (depth)
4" If telescope see back.
(size)
- (5) screen 6" 96'
(length) (depth to top)
4" Plastic
(size) (material)
- (6) pump 3 7
(HP) (yield gpm)
Electric
(type power)
- (7) electric log No
(yes or no)
Electric
(organization running log)
- (8) how well bottom plugged Red clay

CODED

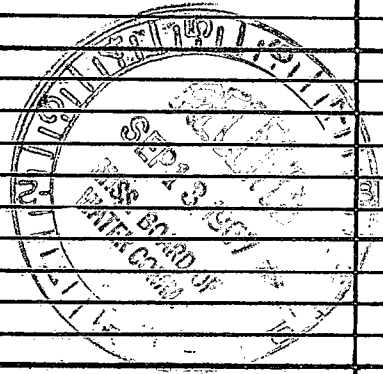

DRILLERS REMARKS:

If well telescopes please sketch and show depths.

GROUND LEVEL

X			

SECTION 15

Please indicate well location X.

ADDITIONAL INFORMATION

If more than one screen, show locations of each on sketch.