

WALTHAM

J 18.

5-68

BODED

MISSISSIPPI
 BOARD OF WATER COMMISSIONERS
 416 North State Street
 Jackson, Mississippi 39201

WATER WELL DRILLERS LOG

5-9

1968 Fitzgerald well serv

waltham

date well completed

firm name

county well located

LANDOWNER:

Leola Austin

description of formations encountered

from

to

OR Tylertown, Miss.
(mailing address)

Beel clay	0	15
Beel sand	15	120
Fine sand	120	160
Beel clay	160	170
Fine sand	170	180
course sand	180	192

WELL LOCATION:

sec. 23 T 1 N R 11 E
 8 miles SE of Tylertown
 (distance) (direction) (nearest town)

WELL PURPOSE:

Home
(home, irrigation, municipal, industrial)

WELL COMPLETION DATA:

- (1) diameter (inches) 4"
- (2) total depth (feet) 192
- (3) static water level (feet) 95 below top of ground.
- (4) casing Plastic, 186' (material) (depth)
4" (size) if telescope see back.
- (5) screen 6', 186' (length) (depth to top)
4" (size) Plastic (material)
- (6) pump 3 (HP) 3 (yield gpm)
Elex (type power)
- (7) electric log No (yes or no)
(organization running log)
- (8) how well bottom plugged Wood peg


BODED

JAN - 9 1968
 MISS. BOARD OF
 WATER COMMISSIONERS

DRILLERS REMARKS:

If well telescopes please sketch and show depths.

GROUND LEVEL

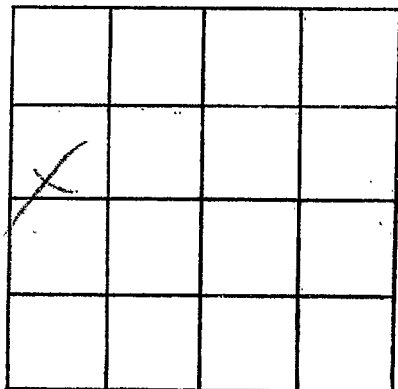

SECTION 23

Please indicate well location X.

ADDITIONAL INFORMATION

If more than one screen, show locations of each on sketch.