

Walthall  
 J 19  
 4-11-67

MISSISSIPPI  
 BOARD OF WATER COMMISSIONERS  
 416 North State Street  
 Jackson, Mississippi 39201

WATER WELL DRILLERS LOG

4-11 1967 Fernie + Elbert Brown Walthall  
 date well completed firm name county well located

LANDOWNER:  
 Till Woods  
 Dybertown miss  
 (mailing address)


| description of formations encountered | from | to  |
|---------------------------------------|------|-----|
| Red clay                              | 0    | 15  |
| Sand & gravel                         | 15   | 67  |
| Blue Clay                             | 67   | 127 |
| Sand & Gravel                         | 127  | 150 |

WELL LOCATION:  
 sec. 17 T 1 N R 11 E  
 S 1 mile from  
 5 M miles SE of Napoleon  
 (distance) (direction) (nearest town)  
 School

WELL PURPOSE:  
 (home, irrigation, municipal, industrial)

WELL COMPLETION DATA:  
 (1) diameter (inches) 4" Plastic  
 (2) total depth (feet)  
 (3) static water level (feet) \_\_\_\_\_ below  
 top of ground. above  
 (4) casing Plastic (material), (depth)  
 \_\_\_\_\_ if telescope see back.  
 (size)  
 (5) screen 5 145 (length) (depth to top)  
 \_\_\_\_\_ (size), \_\_\_\_\_ (material)  
 (6) pump 1 7 (HP) (yield gpm)  
 Elec (type power)  
 (7) electric log \_\_\_\_\_ (yes or no)  
 \_\_\_\_\_ (organization running log)  
 (8) how well bottom plugged W V


CODED

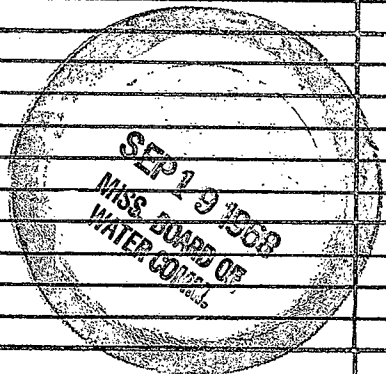

DRILLERS REMARKS:

If well telescopes please sketch and show depths.

GROUND LEVEL

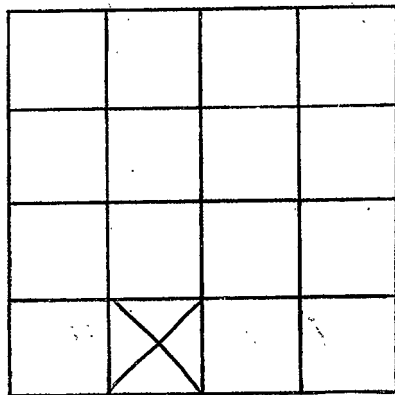

SECTION 17

Please indicate well location X.

ADDITIONAL INFORMATION

If more than one screen, show locations of each on sketch.