

**MISSISSIPPI
BOARD OF WATER COMMISSIONERS**
416 North State Street
Jackson, Mississippi 39201

WATER WELL DRILLERS LOG

Walthall
J20
4-26-68

CODED

4 26 1968 Fernie & Elbert Brown Walthall
date well completed firm name county well located

LANDOWNER:

Garland Maggee

(mailing address)

description of formations encountered

Red clay
sand
brance

from	to
<u>0</u>	<u>25</u>
<u>25</u>	<u>65</u>
<u>65</u>	<u>78</u>

WELL LOCATION:

sec. ~~33~~ 1 N R. 11 E
6 miles SE of Zyher Town
(distance) (direction) (nearest town)


WELL PURPOSE: Home
(home, irrigation, municipal, industrial)

WELL COMPLETION DATA:

- (1) diameter (inches) 4
- (2) total depth (feet) ~~73~~ 78
- (3) static water level (feet) 65 below top of ground.
- (4) casing 4" 73
(material) (depth)
if telescope see back.
(size)
- (5) screen 5 73
(length) (depth to top)
(size) (material)
- (6) pump 1 8
(HP) (yield gpm)
5hp
(type power)
- (7) electric log _____
(yes or no)
(organization running log)
- (8) how well bottom plugged W.P.


CODED

DRILLERS REMARKS:

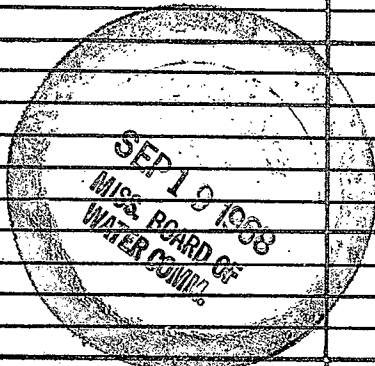

If well telescopes please sketch and show depths.

GROUND LEVEL

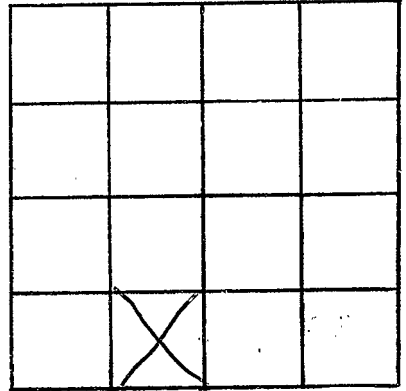

SECTION 35

Please indicate well location X.

ADDITIONAL INFORMATION

If more than one screen,
show locations of each on sketch.