

**MISSISSIPPI
BOARD OF WATER COMMISSIONERS**
416 North State Street
Jackson, Mississippi 39201

WATER WELL DRILLERS LOG

Walthall
921
8-68 **CODED**

8-6- date well completed Walthall firm name Walthall county well located

LANDOWNER: M.T. Thomas
Sandy Hook, Rt 115
(mailing address)


WELL LOCATION:
see 36 T 1 N 11 E
 S W
16 miles SE of Tylertown
(distance) (direction) (nearest town)

WELL PURPOSE: home
(home, irrigation, municipal, industrial)

- WELL COMPLETION DATA:
- (1) diameter (inches) 13 1/2
 - (2) total depth (feet) 131
 - (3) static water level (feet) 115 below above top of ground.
 - (4) casing plastic 131
(material) (depth)
4 If telescope see back.
(size)
 - (5) screen 6' 131
(length) (depth to top)
4 sch 40
(size) (material)
 - (6) pump 1 1
(HP) (yield gpm)
Eford
(type power)
 - (7) electric log no
(yes or no)
(organization running log)
 - (8) how well bottom plugged Walt pag

description of formations encountered	from	to
top soil & clay	0	5
sand	5	18
gravel	18	60
sand	60	125
gravel & sand	125	131
chalk		

CODED

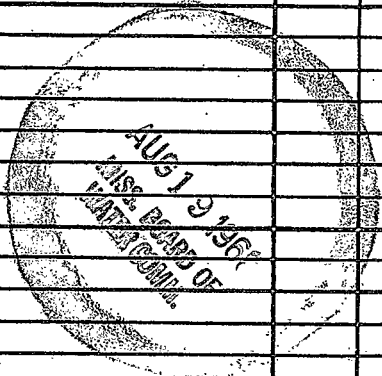

DRILLERS REMARKS:

If well telescopes please sketch and show depths.

GROUND LEVEL

SECTION _____

Please indicate well location X.

ADDITIONAL INFORMATION

If more than one screen, show locations of each on sketch.