

INDEX

Walthall
J 22
12-12-68

MISSISSIPPI
BOARD OF WATER COMMISSIONERS
416 North State Street
Jackson, Mississippi 39201

WATER WELL DRILLERS LOG

Dec 12 1968 Reeves well drillers Walthall
date well completed firm name county well located

LANDOWNER: M. Rattiff
RFD #10 Winterton
(mailing address)

description of formations encountered	from	to
Red sandy clay	0	16
Red sand	16	60
Red gravel sand	60	67
White chalk	67	140
Coarse pink sand	150	160

WELL LOCATION:
sec. 4 T 1 N R 11 E
3 1/2 miles S.E. of Winterton
(distance) (direction) (nearest town)

WELL PURPOSE: Home
(home, irrigation, municipal, industrial)

WELL COMPLETION DATA:

(1) diameter (inches) - 4"

(2) total depth (feet) - 160

(3) static water level (feet) 76 below top of ground.

(4) casing Plastic bottom
(material) (depth)

(size) if telescope see back.

(5) screen 6' 154
(length) (depth to top)
4" (size) Plastic (material)

(6) pump old pump by owner
(HP) (yield gpm)
(type power)

(7) electric log No -
(yes or no)

(organization running log)

(8) how well bottom plugged
wooden plug

DRILLERS REMARKS:
old well try.


INDEX

APR 22 1968

MISS. BD. OF
WATER COMM.

If well telescopes please sketch and show depths.

GROUND LEVEL

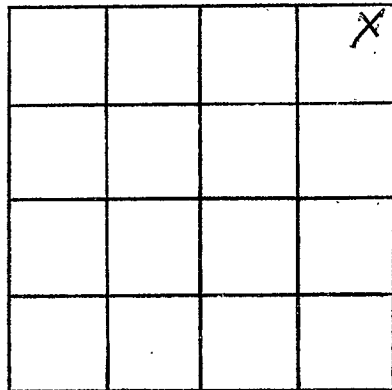

SECTION 14

Please indicate well location X.

ADDITIONAL INFORMATION

If more than one screen, show locations of each on sketch.