

**MISSISSIPPI  
BOARD OF WATER COMMISSIONERS**  
416 North State Street  
Jackson, Mississippi 39201

**CODED**

**WATER WELL DRILLERS LOG**

Walthall  
J 23  
6-69

6-5 19 69 Walthall  
date well completed firm name county well located

**LANDOWNER:**  
Tom Daley  
RR Tylertown, Miss.  
(mailing address)

description of formations encountered	from	to
<u>Red clay</u>	<u>0</u>	<u>20</u>
<u>Red sand</u>	<u>20</u>	<u>60</u>
<u>Red gravel</u>	<u>60</u>	<u>85</u>
<u>Blue clay</u>	<u>85</u>	<u>190</u>
<u>Coarse sand</u>	<u>190</u>	<u>210</u>

**WELL LOCATION:**  
sec. 6 T 1 N R 11 E  
3 miles SE of Tylertown  
(distance) (direction) (nearest town)

**WELL PURPOSE:** Home  
(home, irrigation, municipal, industrial)

- WELL COMPLETION DATA:**
- (1) diameter (inches) 4
  - (2) total depth (feet) 210
  - (3) static water level (feet) 90 below top of ground.
  - (4) casing Plastic 204  
(material) (depth)  
4 if telescope see back.  
(size)
  - (5) screen 6, 204  
(length) (depth to top)  
4, plastic  
(size) (material)
  - (6) pump 1/2, 10  
(HP) (yield gpm)  
Elco  
(type power)
  - (7) electric log no  
(yes or no)  
(organization running log)
  - (8) how well bottom plugged good


**DRILLERS REMARKS:**

**PAGE 4**

MISS. BD. OF  
WATER COMMISSIONERS

If well telescopes please sketch and show depths.

GROUND LEVEL

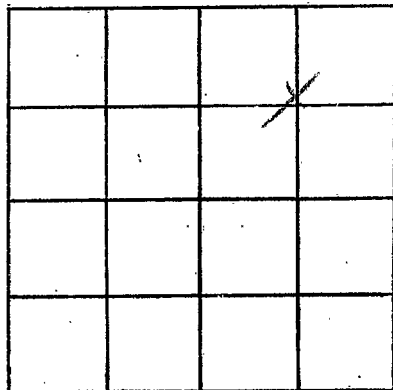

SECTION 6

Please indicate well location X.

ADDITIONAL INFORMATION

If more than one screen,  
show locations of each on sketch.