

WALTHALL  
J 24  
11-21-69

MISSISSIPPI  
BOARD OF WATER COMMISSIONERS  
416 North State Street  
Jackson, Mississippi 39201

CODED  
CODED

WATER WELL DRILLERS LOG

11-21 1969 Fitzgerald Well Serv Walthall  
date well completed firm name county well located

LANDOWNER:  
Porter McKenzie  
P.O. Tylertown Miss  
(mailing address)

description of formations encountered	from	to
<u>Red Clay</u>	<u>0</u>	<u>15</u>
<u>Red Sand</u>	<u>15</u>	<u>90</u>
<u>Red ground</u>	<u>90</u>	<u>160</u>
<u>Red Clay</u>	<u>100</u>	<u>130</u>
<u>Coarse Sand</u>	<u>130</u>	<u>142</u>

WELL LOCATION:  
sec. 13 T 1 N R 11 E  
S W  
7 miles ESE of Tylertown  
(distance) (direction) (nearest town)

WELL PURPOSE: Home  
(home, irrigation, municipal, industrial)


- WELL COMPLETION DATA:
- (1) diameter (inches) 4
  - (2) total depth (feet) 142
  - (3) static water level (feet) 80 below above top of ground.
  - (4) casing Aluminum, 136 (material) (depth)  
4 if telescope see back. (size)
  - (5) screen 6, 136 (length) (depth to top)  
4, Aluminum (size) (material)
  - (6) pump 1/2, 10 (HP) (yield gpm)  
Gas (type power)
  - (7) electric log no (yes or no)  
(organization running log)
  - (8) how well bottom plugged usual way

DRILLERS REMARKS:

DEC 22 1969  
Miss. Bd. of  
WATER COMM.

If well telescopes please sketch and show depths.

GROUND LEVEL

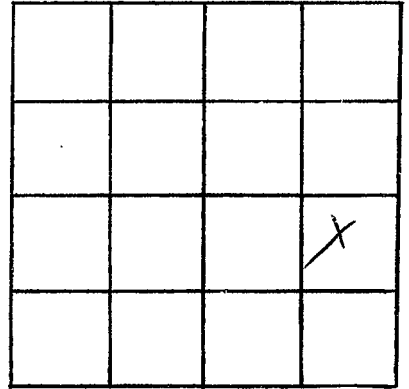

SECTION 13

Please indicate well location X.

ADDITIONAL INFORMATION

If more than one screen,  
show locations of each on sketch.