

WALTHALL
J 25
12-16-69

MISSISSIPPI
BOARD OF WATER COMMISSIONERS
416 North State Street
Jackson, Mississippi 39201

CODED
CODED

WATER WELL DRILLERS LOG

12-16 1969 Fitzgibbon well dr Walthall
date well completed firm name county well located

LANDOWNER:
Roy Blackwell
M. Tylston Miss
(mailing address)

description of formations encountered	from	to
<u>Red clay</u>	<u>0</u>	<u>20</u>
<u>Red sand</u>	<u>20</u>	<u>60</u>
<u>Coarse sand & gravel</u>	<u>60</u>	<u>82</u>

WELL LOCATION:
sec 3 T 1 N R 11 E
S W
6 miles ESE of Tylston
(distance) (direction) (nearest town)

WELL PURPOSE: Home
(home, irrigation, municipal, industrial)

- WELL COMPLETION DATA:
- (1) diameter (inches) 4
 - (2) total depth (feet) 82
 - (3) static water level (feet) 35 below above top of ground.
 - (4) casing galvanized 74
(material) (depth)
4 if telescope see back.
(size)
 - (5) screen 8 74
(length) (depth to top)
4 galvanized
(size) (material)
 - (6) pump ? ?
(HP) (yield gpm)
?
(type power)
 - (7) electric log no
(yes or no)
(organization running log)
 - (8) how well bottom plugged wood plug


DRILLERS REMARKS:

DEC 22 1969

MISS. Bd. of WATER WELL DRILLERS SURVEY

If well telescopes please sketch and show depths.

GROUND LEVEL

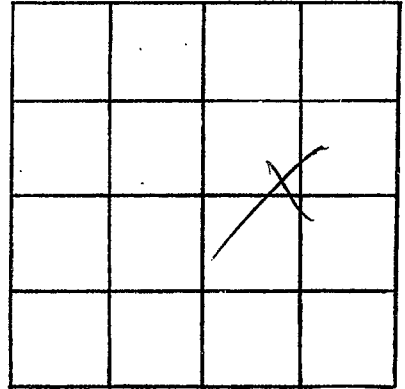

SECTION 3

Please indicate well location X.

ADDITIONAL INFORMATION

If more than one screen,
show locations of each on sketch.