

WALTHALL
J 28
10-22-70

MISSISSIPPI
 BOARD OF WATER COMMISSIONERS
 416 North State Street
 Jackson, Mississippi 39201

CODED

WATER WELL DRILLERS LOG

10-22 1970 Fitzgerald Well Dr Walthall
 date well completed firm name county well located

LANDOWNER:
Freddie Jean
R.P. Gibson miss
 (mailing address)

description of formations encountered	from	to
<u>Red Clay</u>	<u>0</u>	<u>20</u>
<u>Red Sand</u>	<u>20</u>	<u>100</u>
<u>Coarse Sand</u>	<u>100</u>	<u>114</u>

WELL LOCATION:
 sec. 3 T 1 N R 11 E
6 miles SE of Gibson
 (distance) (direction) (nearest town)

WELL PURPOSE: Home
 (home, irrigation, municipal, industrial)

- WELL COMPLETION DATA:
- (1) diameter (inches) 4
 - (2) total depth (feet) 114
 - (3) static water level (feet) 40 below above top of ground.
 - (4) casing plastic, 108,
 (material) (depth)
4 if telescope see back.
 (size)
 - (5) screen 6, 108
 (length) (depth to top)
4, plastic
 (size) (material)
 - (6) pump 3/4, 5
 (HP) (yield gpm)
cb
 (type power)
 - (7) electric log no
 (yes or no)
 (organization running log)
 - (8) how well bottom plugged Wooly

CODED


NOV 9 - 1970

DRILLERS REMARKS:

MISC. DE. OF WATER

If well telescopes please sketch and show depths.

GROUND LEVEL

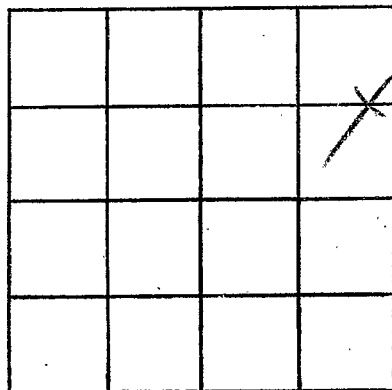

SECTION 3

Please indicate well location X.

ADDITIONAL INFORMATION

If more than one screen, show locations of each on sketch.