

WALTHALL
J 29
11-3-70

MISSISSIPPI
BOARD OF WATER COMMISSIONERS
416 North State Street
Jackson, Mississippi 39201

CODED

WATER WELL DRILLERS LOG

11-3 1970 Fitzgibbon Well Co Walthall
date well completed firm name county well located

LANDOWNER:
O. C. Brock
R.R. Tyltorn, Miss.
(mailing address)

WELL LOCATION:
sec. 5 T 1 N R 11 E
5 miles SE of Tyltorn
(distance) (direction) (nearest town)

WELL PURPOSE: flow
(home, irrigation, municipal, industrial)

WELL COMPLETION DATA:
(1) diameter (inches) 4
(2) total depth (feet) 181
(3) static water level (feet) 60 below above top of ground.
(4) casing Plastic 173
(material) (depth)
4 if telescope see back.
(size)
(5) screen 8 173
(length) (depth to top)
4 Plastic
(size) (material)
(6) pump 3/4 8
(HP) (yield gpm)
el
(type power)
(7) electric log yes
(yes or no)
(organization running log)
(8) how well bottom plugged wood

description of formations encountered	from	to
Red clay	6	20
Red sand	20	80
Coarse sand	80	86
Fine red sand	86	165
Coarse sand	165	181

CODED


NOV 9 - 1970

DRILLERS REMARKS:

MISS. BD. OF
WATER COMMISSIONERS

If well telescopes please sketch and show depths.

GROUND LEVEL

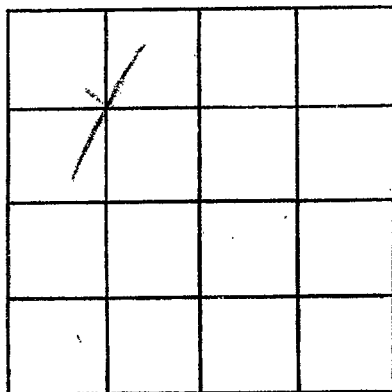

SECTION 5

Please indicate well location X.

ADDITIONAL INFORMATION

If more than one screen, show locations of each on sketch.