

WALTHALL
J 30
10-70

MISSISSIPPI
BOARD OF WATER COMMISSIONERS
416 North State Street
Jackson, Mississippi 39201

CODED

WATER WELL DRILLERS LOG

WALTHALL
~~ATTACHE~~

OCT. 1970 E. B. SHERRARD
date well completed firm name county well located

LANDOWNER:	description of formations encountered	from	to
CLARENCE WEARY TYLERTOWN, MISS. (mailing address)	YELLOW SANDY CLAY MIXED MOSTLY SILT VERY INCONSISTENT @ 74'		74'
WELL LOCATION: sec 23 T 1 N R 11 E 7 miles SE of TYLERTOWN (distance) (direction) (nearest town)	SMALL WHITE SAND & VERY LITTLE PEA GRAVEL GRAY CLAY BASE		74' 90'
WELL PURPOSE: (home) Irrigation, municipal, industrial			
WELL COMPLETION DATA:			
(1) diameter (inches) 2"			
(2) total depth (feet) 90			
(3) static water level (feet) 60 below top of ground.			
(4) casing PL. 85 (material) (depth)			
2" (size) if telescope see back.			
(5) screen 5' (length) (depth to top)			
2" (size) S.S. (material)			
(6) pump 3/4 (HP) 7 (yield gpm)			
E (type power)			
(7) electric log (yes or no)			
(organization running log)			
(8) how well bottom plugged BWV			
DRILLERS REMARKS:			


CODED

FEB 1 1971

MISS. DEP. OF
WATER CONTROL

If well telescopes please
sketch and show depths.

GROUND LEVEL

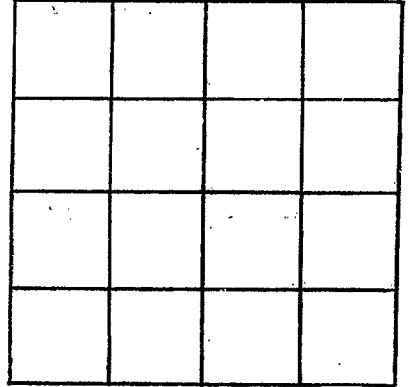

SECTION _____

Please indicate well location X.

ADDITIONAL INFORMATION

If more than one screen,
show locations of each on sketch.