

WALTHALL

J35

3-26-73

MISSISSIPPI BOARD OF WATER COMMISSIONERS 416 North State Street Jackson, Mississippi 39201

CODED

WATER WELL DRILLERS LOG

3-26-73

date well completed

Esby Stafford Waterwell Service Walthall

firm name

county well located

LANDOWNER: Jewell Thomas

RT-7

Iylertown Miss (mailing address)

description of formations encountered

from

to

Top soil & clay

0 20

Chalk

20 40

WELL LOCATION:

sec 36 T-1 N R-11 E

13 miles South of Iylertown (distance) (direction) (nearest town)

Sand & Gravel

40 78

WELL PURPOSE:

(home, irrigation, municipal, industrial)

WELL COMPLETION DATA:

- (1) diameter (inches) 4
(2) total depth (feet) 78 ft
(3) static water level (feet) 12 below above top of ground.
(4) casing Plastic, 58 (material) (depth) 4 (size) if telescope see back.
(5) screen 20 58 (length) (depth to top) 4 in, Plastic (size) (material)
(6) pump 1 30 (HP) (yield gpm)
(7) electric log yes (yes or no)

CODED

(organization running log)

(8) how well bottom plugged


B.W.V.

DRILLERS REMARKS:

Cleve Duncan

If well telescopes please sketch and show depths.

GROUND LEVEL

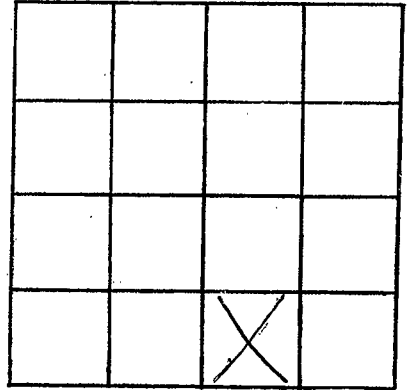

SECTION _____

Please indicate well location X.

ADDITIONAL INFORMATION

If more than one screen,
show locations of each on sketch.