

WALTHALL
J37
12-10-73

MISSISSIPPI
BOARD OF WATER COMMISSIONERS
416 North State Street
Jackson, Mississippi 39201

CODED

WATER WELL DRILLERS LOG

Walthall
Mississippi

12-10 1973
date well completed

Fidelity Label Sew
firm name

county well located

LANDOWNER:

Bonnie Leaser
P.R. Feltman
(mailing address)

description of formations encountered

description of formations encountered	from	to
Red Clay	0	20
Red sand	20	85
Coarse sand gravel	85	100

WELL LOCATION:

sec. 1 T 1 N R 11 E
S W
7 miles SE of Feltman
(distance) (direction) (nearest town)

WELL PURPOSE:

Home (home, irrigation, municipal, industrial)

WELL COMPLETION DATA:

- (1) diameter (inches) 4
- (2) total depth (feet) 100
- (3) static water level (feet) 85 below top of ground.
- (4) casing plastic 92 (material) (depth)
4 (size) if telescope see back.
- (5) screen 8 92 (length) (depth to top)
4 (size) plastic (material)
- (6) pump 1/2 10 (HP) (yield gpm)
plastic (type power)
- (7) electric log (yes or no)
- (8) how well bottom plugged (wood plug)

CODED

MISSISSIPPI
BOARD OF WATER COMMISSIONERS


JAN 22 1974

DRILLERS REMARKS:

MISSISSIPPI
BOARD OF WATER COMMISSIONERS

If well telescopes please sketch and show depths.

GROUND LEVEL

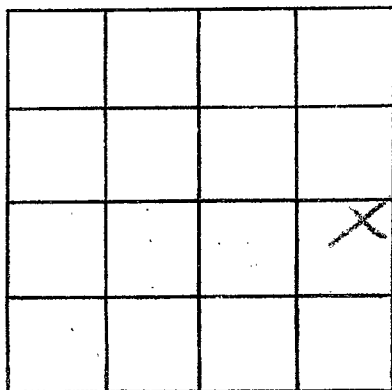

SECTION /

Please indicate well location X.

ADDITIONAL INFORMATION

Lined area for additional information, consisting of approximately 20 horizontal lines.

If more than one screen, show locations of each on sketch.