

WALTHALL
J 38
5-3-74

MISSISSIPPI
BOARD OF WATER COMMISSIONERS
416 North State Street
Jackson, Mississippi 39201

CODED

WATER WELL DRILLERS LOG

5-3
date well completed

24 Ferguson Well Service
firm name

Walthall
county well located

LANDOWNER:

Walter Fortenberry

R.R. Fyler
(mailing address)

description of formations encountered

from

to

Red Clay	0	20
Red Sand	20	100
Green Sand	100	112

WELL LOCATION:

sec. 1 T. 1 N. 11 E. S. 1
6 miles E of Fyler
(distance) (direction) (nearest town)

WELL PURPOSE: Home
(home, irrigation, municipal, industrial)

WELL COMPLETION DATA:

- (1) diameter (inches) 4
- (2) total depth (feet) 112
- (3) static water level (feet) 80 below top of ground.
- (4) casing: plastic 104
(material) (depth)
4 if telescope see back.
(size)
- (5) screen: 8 104
(length) (depth to top)
4 plastic
(size) (material)
- (6) pump: 1/2 10
(HP) (yield gpm)
air
(type power)
- (7) electric log no
(yes or no)
(organization running log)
- (8) how well bottom plugged: Salter


CODED

DRILLERS REMARKS:

WALTHALL COUNTY
MAY 10 1974

If well telescopes please sketch and show depths.

GROUND LEVEL

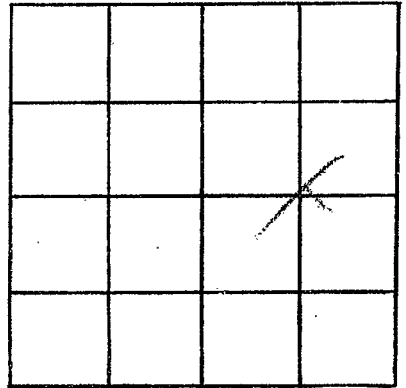

SECTION /

Please indicate well location X.

ADDITIONAL INFORMATION

If more than one screen,
show locations of each on sketch.