

WALTHALL  
J-39  
1-7-75

MISSISSIPPI  
BOARD OF WATER COMMISSIONERS  
416 North State Street  
Jackson, Mississippi 39201

CODED

WATER WELL DRILLERS LOG

Jan 7 1975 Chester Keener Walthall  
date well completed firm name county well located

LANDOWNER:  
Vern Kortenkerry  
Rd. Tylertown  
(mailing address)


| description of formations encountered | from       | to         |
|---------------------------------------|------------|------------|
| <u>Red Sandy Clay</u>                 | <u>0</u>   | <u>50</u>  |
| <u>sandy shale</u>                    | <u>50</u>  | <u>65</u>  |
| <u>Red Chalk</u>                      | <u>65</u>  | <u>114</u> |
| <u>med. coarse sand</u>               | <u>114</u> | <u>162</u> |

WELL LOCATION:  
sec. 28 T 1 N R 11 E  
12 miles S-E of Tylertown  
(distance) (direction) (nearest town)

WELL PURPOSE: home  
(home, irrigation, municipal, industrial)

- WELL COMPLETION DATA:
- (1) diameter (inches) 4
  - (2) total depth (feet) 162
  - (3) static water level (feet) 86 below top of ground.
  - (4) casing plastic bottom  
(material) (depth)
  - If telescope see back.  
(size)
  - (5) screen 6' 156  
(length) (depth to top)
  - 4 plastic  
(size) (material)
  - (6) pump 1/2 sub 10  
(HP) (yield gpm)
  - elect  
(type power)
  - (7) electric log no  
(yes or no)
  - (organization running log)
  - (8) how well bottom plugged woody

CODED

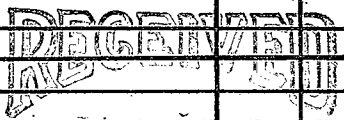


DRILLERS REMARKS:  
new house site

FEB 7 1975

If well telescopes please sketch and show depths.

GROUND LEVEL

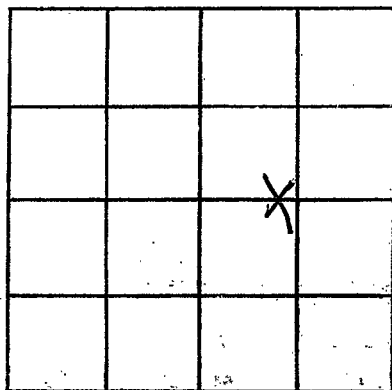

SECTION 11

Please indicate well location X.

ADDITIONAL INFORMATION

If more than one screen, show locations of each on sketch.