

Walthall
 J 40
 5-20-75

MISSISSIPPI
 BOARD OF WATER COMMISSIONERS
 416 North State Street
 Jackson, Mississippi 39201

CODED

WATER WELL DRILLERS LOG

May 20 1975 Beavers Well Drilling Service Walthall
 date well completed firm name county well located

LANDOWNER:

description of formations encountered

from to

Mrs. Inez Phillips
 Rt. 1, Tyltown
 (mailing address)

Red Clay 0 16
 White Sand 16 30
 Red Chalk & sand 30 105
 Coarse Sand 105 118

WELL LOCATION:

sec. 2 T~~1~~ N R 11 E 13 V
 3 1/2 miles E-SF of Tyltown
 (distance) (direction) (nearest town)

WELL PURPOSE: Rome
 (home, irrigation, municipal, industrial)

WELL COMPLETION DATA:

- (1) diameter (inches) 4"
- (2) total depth (feet) 118
- (3) static water level (feet) 17 below top of ground.
- (4) casing plastic, bottom
 (material) (depth)
- If telescope see back.
 (size)
- (5) screen 6 112
 (length) (depth to top)
- 4" plastic
 (size) (material)
- (6) pump 1/2 sub 10
 (HP) (yield gpm)
- elect
 (type power)
- (7) electric log no
 (yes or no)

(organization running log)

(8) how well bottom plugged

wooden plug


DRILLERS REMARKS:

new house site

RECEIVED
 AUG 6 1975

If well telescopes please sketch and show depths.

GROUND LEVEL

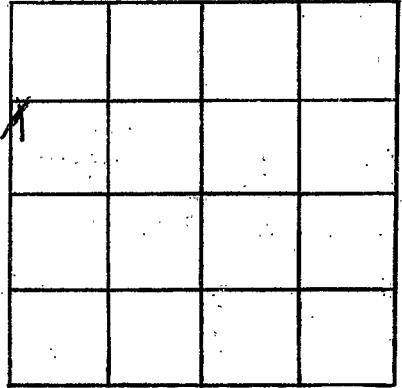

SECTION 2

Please indicate well location X.

ADDITIONAL INFORMATION

If more than one screen, show locations of each on sketch.