

WALTHALL
J48
10/7/80

MISSISSIPPI
BOARD OF WATER COMMISSIONERS
416 North State Street
Jackson, Mississippi 39201

CODED

WATER WELL DRILLERS LOG

Griner Drilling Service, Inc. *Walthall*

10-7-80
date well completed

firm name

county well located

LANDOWNER:
Louisiana Land Explorations
P.O. Box 60350
New Orleans, La.
(mailing address) *70160*

description of formations encountered	from	to
gravel	0	68
chalk	68	105
sand & pea gravel	105	273
chalk	273	311
sand and pea gravel	311	462

WELL LOCATION: *2000' N + 1250' E*
cc. 35 T 1 N R 11 E of
Jewell
D. Thomas
8 1/2 miles
(distance) *SE* (direction) *of* *Thibodaux*
SE of Thibodaux

WELL PURPOSE:
(home, irrigation, municipal, industrial)

WELL COMPLETION DATA:

- (1) diameter (inches) 4"
- (2) total depth (feet) 462'
- (3) static water level (feet) 100' (below top of ground)
- (4) casing steel, 462'
(material) (depth)
4"
(size) If telescope see back.
- (5) screen 42', 420'
(length) (depth to top)
4", perforated
(size) (material)
- (6) pump 80
(HP) (yield gpm)
ac
(type power)
- (7) electric log —
(yes or no)

(organization running log)

(8) how well bottom plugged orange pebb

DRILLERS REMARKS:


DEPT. OF NATURAL RESOURCES
BUREAU OF LAND & WATER RESOURCES

OCT 23 1980

RECEIVED

If well telescopes please sketch and show depths.

GROUND LEVEL

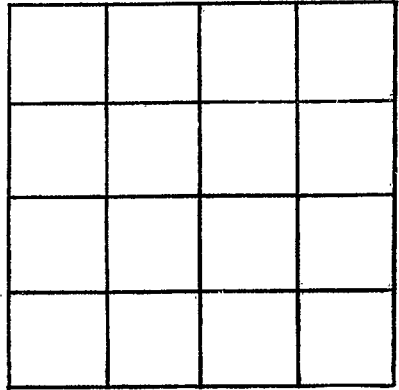

SECTION _____

Please indicate well location X.

ADDITIONAL INFORMATION

If more than one screen, show locations of each on sketch.