

Walthall

J 2000

10-3-75

MISSISSIPPI BOARD OF WATER COMMISSIONERS  
416 North State Street  
131 Jackson, Mississippi 39201

WATER WELL DRILLERS LOG

10/12/75 date well completed

1975 Stafford Well Dr. firm name

Walthall county well located

LANDOWNER:

Adroy Brown

(mailing address)

WELL LOCATION:

sec. 1 T. 11N R. 8E  
5 miles S. East of Ithaca  
(distance) (direction) (nearest town)

WELL PURPOSE: Home  
(home, irrigation, municipal, industrial)

WELL COMPLETION DATA:

- (1) diameter (inches) 4"
- (2) total depth (feet) 132 ft.
- (3) static water level (feet) 110 below top of ground.
- (4) casing plastic 125 ft.  
(material) (depth)  
4" if telescope see back.  
(size)
- (5) screen 10 ft. 120 ft.  
(length) (depth to top)  
4" plastic  
(size) (material)
- (6) pump 1/2 10  
(HP) (yield gpm)  
Pletta  
(type power)
- (7) electric log (yes or no)
- (organization running log)
- (8) how well bottom plugged B.W.U.


description of formations encountered

from to

top soil	0	4
clay soil	4	35
chalk	35	70
sand	70	100
sand & gravel	100	130

DRILLERS REMARKS:


Salvage Pipes

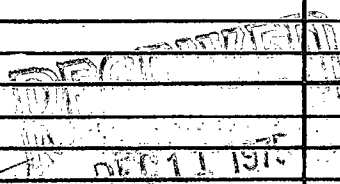

MISS. BD. OF WATER COMMISSIONERS

If well telescopes please sketch and show depths.

GROUND LEVEL

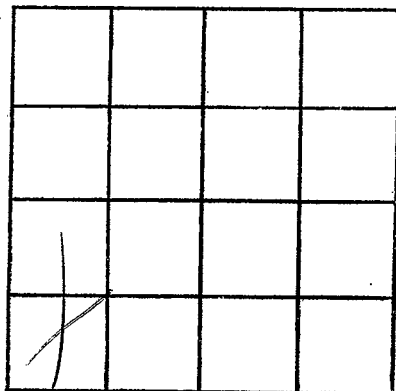

SECTION \_\_\_\_\_

Please indicate well location X.

ADDITIONAL INFORMATION

If more than one screen,  
show locations of each on sketch.