

Walthall
J 2001
11-18-75

MISSISSIPPI
 BOARD OF WATER COMMISSIONERS
 416 North State Street
 Jackson, Mississippi 39201

WATER WELL DRILLERS LOG

11/18/75 19
 date well completed

Stoffer Wells Dr.
 firm name

Walthall
 county well located

LANDOWNER: Wendell Dutton

description of formations encountered

from

to

Top Soil	0	3
clay & gravel	3	40
chalk & sand	40	100
sand	100	115
sand & peagranul	115	135

(mailing address)

WELL LOCATION:

sec. 2 T. 10 S. R. 10 E.
4 miles S-SE of Jackson
 (distance) (direction) (nearest town)

WELL PURPOSE: Home
 (home, irrigation, municipal, industrial)

WELL COMPLETION DATA:

- (1) diameter (inches) 4"
- (2) total depth (feet) 135 ft.
- (3) static water level (feet) 110 below above top of ground.
- (4) casing plastic, 125 ft.
 (material) (depth)
4" If telescope see back.
 (size)
- (5) screen 10 ft., 125 ft.
 (length) (depth to top)
4" plastic
 (size) (material)
- (6) pump 1/2 hp. 10
 (HP) (yield gpm)
elect.
 (type power)
- (7) electric log _____
 (yes or no)

(organization running log)

(8) how well bottom plugged B.W.U.

DRILLERS REMARKS:


Salvage Dishes

DEC 11 1975

MISS. BOARD OF WATER COMMISSIONERS

If well telescopes please sketch and show depths.

GROUND LEVEL

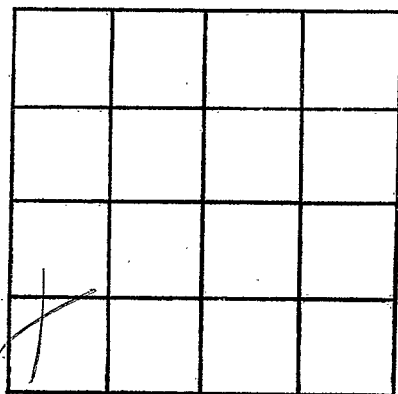

SECTION _____

Please indicate well location X.

ADDITIONAL INFORMATION

If more than one screen,
show locations of each on sketch.