

Walthall  
J 2002  
4/2/76

MISSISSIPPI  
 BOARD OF WATER COMMISSIONERS  
 416 North State Street  
 Jackson, Mississippi 39201

WATER WELL DRILLERS LOG

4/2 <sup>132</sup> Stafford Well Services Walthall  
 date well completed firm name county well located

LANDOWNER John Dillon  
Syltator Miss  
 (mailing address)

description of formations encountered	from	to
top soil	0	2
clay	2	30
sand & gravel	30	70
fine sand	70	90
sand	90	110

WELL LOCATION:  
 sec. 31 T-1 N R-11 E  
10 miles S of Syltator  
 (distance) (direction) (nearest town)

WELL PURPOSE:  
 (home, irrigation, municipal, industrial)

WELL COMPLETION DATA:

(1) diameter (inches) 4"

(2) total depth (feet) 110

(3) static water level (feet) \_\_\_\_\_ below above top of ground.

(4) casing plastic, 100  
 (material) (depth)  
4" if telescope see back.  
 (size)

(5) screen 10ft, 100  
 (length) (depth to top)  
4" plastic  
 (size) (material)

(6) pump 1/2 HP \_\_\_\_\_  
 (HP) (yield gpm)  
Electric  
 (type power)

(7) electric log \_\_\_\_\_  
 (yes or no)

\_\_\_\_\_  
 (organization running log)

(8) how well bottom plugged BWU


DRILLERS REMARKS:  
[Signature]

RECEIVED  
 OCT - 1 1976

MISS. BD. OF WATER COMMISSIONERS

If well telescopes please sketch and show depths.

GROUND LEVEL

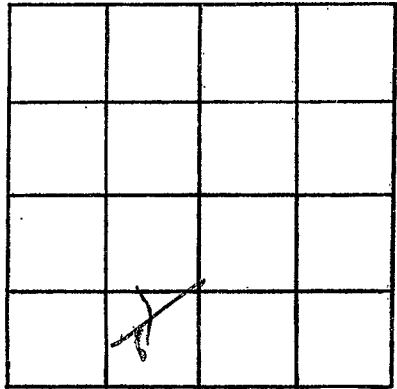

SECTION \_\_\_\_\_

Please indicate well location X.

ADDITIONAL INFORMATION

If more than one screen,  
show locations of each on sketch.

11