

WALTHALL

J 2003

6-9-76

MISSISSIPPI BOARD OF WATER COMMISSIONERS  
416 North State Street  
Jackson, Mississippi 39201

WATER WELL DRILLERS LOG

6/9

1976 Hollinger Plumb

Walthall

date well completed

firm name

county well located

LANDOWNER: Selw. Cotton

Rt. 1 Box 143A

Dexter, Miss.  
(mailing address)

WELL LOCATION:

sec. 12 T-1 (N) R-11 (E)

5 miles west of Dexter  
(distance) (direction) (nearest town)

WELL PURPOSE: Home  
(home, irrigation, municipal, industrial)

WELL COMPLETION DATA:

- (1) diameter (inches) 4"
- (2) total depth (feet) 120 ft.
- (3) static water level (feet) 80 below above top of ground.

(4) casing 4" pvc, 120 ft.  
(material) (depth)

No if telescope see back.  
(size)

(5) screen 5 ft., 115  
(length) (depth to top)

4", pvc  
(size) (material)

(6) pump 1/2, 15  
(HP) (yield gpm)

elect  
(type power)

(7) electric log No  
(yes or no)

N  
(organization running log)

(8) how well bottom plugged back  
wash w/ pvc

DRILLERS REMARKS: good

description of formations encountered

from


to

c. 1/2 ft  
clay & sand  
sand

0 40  
110 80  
120 120

If well telescopes please sketch and show depths.

GROUND LEVEL

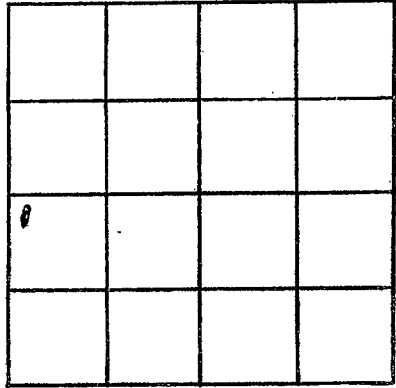

SECTION 12

Please indicate well location X.

ADDITIONAL INFORMATION

If more than one screen, show locations of each on sketch.