

Walthall
J 200
Jan. 1977

MISSISSIPPI
BOARD OF WATER COMMISSIONERS
416 North State Street
Jackson, Mississippi 39201

WATER WELL DRILLERS LOG

Jan. 1977 19 *Hofford Well Service* *Walthall*
date well completed firm name county well located

LANDOWNER:
Doy Saaved
Fayetteville Miss
(mailing address)

description of formations encountered	from	to
<i>top soil</i>	<i>0</i>	<i>2</i>
<i>clay & gravel</i>	<i>2</i>	<i>60</i>
<i>chalk & clay</i>	<i>60</i>	<i>145</i>
<i>sand & gravel</i>	<i>145</i>	<i>165</i>

WELL LOCATION:
sec. *11* T *1* N R *10E*
S W
10 miles *SSE* of *Fayetteville*
(distance) (direction) (nearest town)

WELL PURPOSE: *none*
(home, irrigation, municipal, industrial)

- WELL COMPLETION DATA:
- (1) diameter (inches) *4"*
 - (2) total depth (feet) *165ft*
 - (3) static water level (feet) *80* below / above top of ground.
 - (4) casing *plastic, 155ft*
(material) (depth)
4" If telescope see back.
(size)
 - (5) screen *10ft*, *155*
(length) (depth to top)
4", *plastic*
(size) (material)
 - (6) pump _____
(HP) (yield gpm)
(type power)
 - (7) electric log _____
(yes or no)
(organization running log)
 - (8) how well bottom plugged *BWU*


DRILLERS REMARKS: *[Signature]*

RECEIVED
MAR 18 1977

MISS. Bd. OF WATER COMM.

If well telescopes please sketch and show depths.

GROUND LEVEL

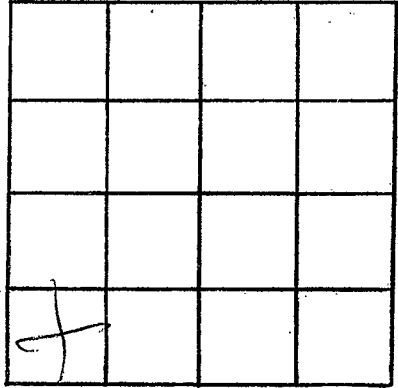

SECTION _____

Please indicate well location X.

ADDITIONAL INFORMATION

If more than one screen,
show locations of each on sketch.