

WALTHALL
J 205
3-17-77

MISSISSIPPI
 BOARD OF WATER COMMISSIONERS
 416 North State Street
 Jackson, Mississippi 39201

WATER WELL DRILLERS LOG

3-17 19 77 Fitzgerald Well Serv Walthall
 date well completed firm name county well located

LANDOWNER:

Milton Thornhill
R.R. by Lutown, Miss.
 (mailing address)

description of formations encountered

from to

<u>Red clay</u>	<u>0</u>	<u>20</u>
<u>Red sand</u>	<u>20</u>	<u>60</u>
<u>White chalk</u>	<u>60</u>	<u>130</u>
<u>Coarse sand & gravel</u>	<u>130</u>	<u>160</u>

WELL LOCATION:

sec. 10 T. 1 N. R. 1 E
9 miles SE of Lutown
 (distance) (direction) (nearest town)

WELL PURPOSE:

Home
 (home, irrigation, municipal, industrial)

WELL COMPLETION DATA:

- (1) diameter (inches) 4
- (2) total depth (feet) 160
- (3) static water level (feet) 70 below above top of ground.
- (4) casing PVC, 152,
 (material) (depth)
4 if telescope see back.
 (size)
- (5) screen 8, 152
 (length) (depth to top)
4, PVC
 (size) (material)
- (6) pump 1/2, 76
 (HP) (yield gpm)
elec
 (type power)
- (7) electric log no
 (yes or no)
 (organization running log)
- (8) how well bottom plugged sand block


DRILLERS REMARKS:

RECEIVED
 MAR 30 1977

MISS. BD. OF WATER COMMISSIONERS

If well telescopes please sketch and show depths.

GROUND LEVEL

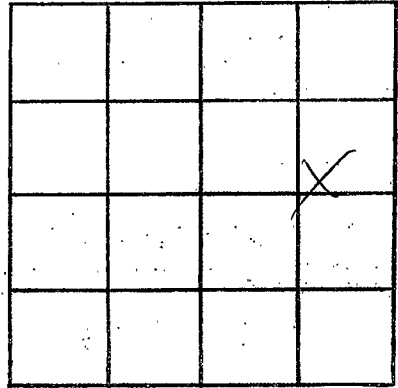

SECTION 10

Please indicate well location X.

ADDITIONAL INFORMATION

If more than one screen,
show locations of each on sketch.