

WALTHALL
 J ~~DOE~~
 5-15-77

MISSISSIPPI
 BOARD OF WATER COMMISSIONERS
 416 North State Street
 Jackson, Mississippi 39201

WATER WELL DRILLERS LOG

5-15-1977 Red Muck Water Well Walthall
 date well completed firm name county well located

LANDOWNER:

Lela J Buchanan

RT-7-Box 33 Tyler town, Miss
 (mailing address) 39667

WELL LOCATION:

sec. 13 T 1 N R 11 E
 S W

0.6 ± miles S/E of Tyler town
 (distance) (direction) (nearest town)

WELL PURPOSE: Home
 (home, irrigation, municipal, industrial)

WELL COMPLETION DATA:

- (1) diameter (inches) 4"
- (2) total depth (feet) 140
- (3) static water level (feet) 110 below top of ground.
- (4) casing PVC 140 (material) (depth)
 (size) if telescope see back.
- (5) screen 10' 130 (length) (depth to top)
 4" PVC (size) (material)
- (6) pump 1/2 8 (HP) (yield gpm)
 115 Volt AC (type power)
- (7) electric log (yes or no)
 (organization running log)
- (8) how well bottom plugged
 2" sand sharp V-shape

description of formations encountered

from to

Top clay	0	25
Red top sand	25	85
White to blue chalk	85	120
Line sand	120	135
Coarse sand	135	140


RECEIVED
 MAY 24 1977

DRILLERS REMARKS:

MISS. BD. OF WATER COMMISSIONERS

If well telescopes please sketch and show depths.

GROUND LEVEL

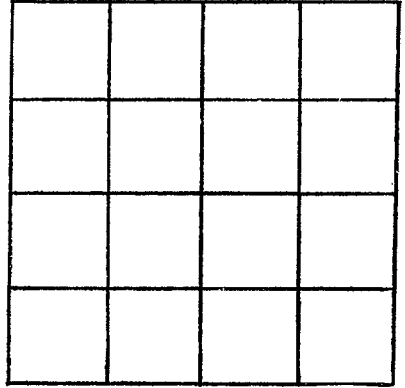

SECTION _____

Please indicate well location X.

ADDITIONAL INFORMATION

If more than one screen,
show locations of each on sketch.