

WALTHALL  
 J 2007  
 6-28-77

MISSISSIPPI  
 BOARD OF WATER COMMISSIONERS  
 416 North State Street  
 Jackson, Mississippi 39201

WATER WELL DRILLERS LOG

6-28 1977 date well completed  
 13V Filander Lee Service firm name  
 Walthall county well located

LANDOWNER:  
 Carson Fortenberry  
 P.O. Fortenberry, Miss.  
 (mailing address)

description of formations encountered	from to	
	feet	feet
Red clay	0	20
Red sand & gravel	20	125
Coarse sand & gravel	125	148

WELL LOCATION:  
 sec. 1 T. 1 N. R. 1 E.  
 S W  
 2.5 miles SE of Fortenberry  
 (distance) (direction) (nearest town)

WELL PURPOSE:  
 Home  
 (home, irrigation, municipal, industrial)

- WELL COMPLETION DATA:
- (1) diameter (inches) 4
  - (2) total depth (feet) 148
  - (3) static water level (feet) 25 below above top of ground.
  - (4) casing PVC, 140, (material) (depth)  
 4 (size) if telescope see back.
  - (5) screen 8, 140 (length) (depth to top)  
 4 (size) PVC (material)
  - (6) pump 1/2 (HP) 10 (yield gpm)  
 Elec (type power)
  - (7) electric log no (yes or no)  
 (organization running log)
  - (8) how well bottom plugged Sand shell


DRILLERS REMARKS:

RECEIVED  
 AUG 29 1977

MISS. BD. OF WATER COMMISSIONERS

If well telescopes please sketch and show depths.

GROUND LEVEL

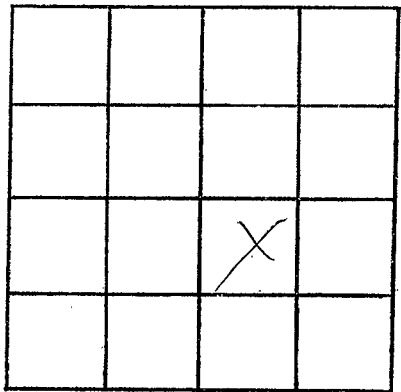

SECTION 1

Please indicate well location X.

ADDITIONAL INFORMATION

If more than one screen, show locations of each on sketch.