

WALTHALL

J 2009

8-17-77

MISSISSIPPI BOARD OF WATER COMMISSIONERS 416 North State Street Jackson, Mississippi 39201

WATER WELL DRILLERS LOG

8-17 1977 date well completed Fitzgerald Well Serv firm name Walthall county well located

Table with columns: LANDOWNER, WELL LOCATION, WELL PURPOSE, WELL COMPLETION DATA, and description of formations encountered. Includes handwritten entries for L. Roy Blackburn, R.B. Tylston, and well completion details like diameter (4 inches), total depth (130 feet), and casing material (PVC).


RECEIVED

AUG 23 1977

MISS. BD. OF WATER COMMISSIONERS

If well telescopes please sketch and show depths.

GROUND LEVEL

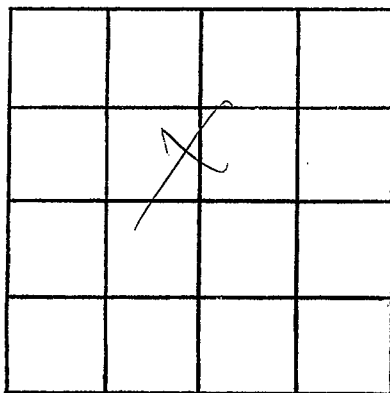

SECTION 10

Please indicate well location X.

ADDITIONAL INFORMATION

If more than one screen,
show locations of each on sketch.