

WALTHALL
J. DOD
6-22-79

MISSISSIPPI
BOARD OF WATER COMMISSIONERS
416 North State Street
Jackson, Mississippi 39201

WATER WELL DRILLERS LOG

6-22-79 19 *Hoffred Well Co.* *Walthall*
date well completed firm name county well located

LANDOWNER:
Hornie Duncan
(mailing address)

description of formations encountered	from	to
<i>top soil</i>	<i>0</i>	<i>2</i>
<i>sand clay</i>	<i>2</i>	<i>50</i>
<i>sand & gravel</i>	<i>50</i>	<i>70</i>

WELL LOCATION:
sec *1* T *10* N R *11* W
5 miles *SE* of *Leakwater*
(distance) (direction) (nearest town)

WELL PURPOSE: *Home*
(home, irrigation, municipal, industrial)

- WELL COMPLETION DATA:
- (1) diameter (inches) *4"*
 - (2) total depth (feet) *70*
 - (3) static water level (feet) *50* below top of ground.
 - (4) casing *plastic 60*
(material) (depth)
4" if telescope see back.
(size)
 - (5) screen *10ft. 60*
(length) (depth to top)
4" plastic
(size) (material)
 - (6) pump *1/2 hp 12*
(HP) (yield gpm)
elect
(type power)
 - (7) electric log (yes or no)
 - (organization running log)
 - (8) how well bottom plugged *BWD*

DRILLERS REMARKS:
[Signature]


DEPT. OF NATURAL RESOURCES
BUREAU OF LAND & WATER
WATER RESOURCES

MAY 27 1980

RECEIVED

If well telescopes please sketch and show depths.

GROUND LEVEL

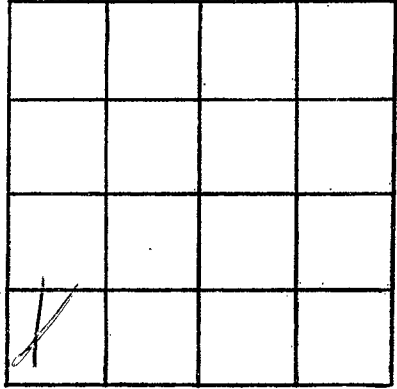

SECTION _____

Please indicate well location X.

ADDITIONAL INFORMATION

If more than one screen, show locations of each on sketch.