

WALTHALL
J 2011
12-19-79

MISSISSIPPI
 BOARD OF WATER COMMISSIONERS
 416 North State Street
 Jackson, Mississippi 39201

WATER WELL DRILLERS LOG

12-19 1979 Fitzgerald Well Serv Walthall
 date well completed firm name county well located

LANDOWNER:
James Dillon
RR. Tylertown
 (mailing address)

| description of formations encountered | from | to |
|---------------------------------------|------------|------------|
| <u>Red clay</u> | <u>0</u> | <u>20</u> |
| <u>Red sand</u> | <u>20</u> | <u>50</u> |
| <u>White & Blue Chalk</u> | <u>50</u> | <u>150</u> |
| <u>Coarse sand & gravel</u> | <u>150</u> | <u>168</u> |

WELL LOCATION:
 sec. 27 T. 1 N R. 11 E
9 miles SSE of Tylertown
 (distance) (direction) (nearest town)

WELL PURPOSE: Home
 (home, irrigation, municipal, industrial)

WELL COMPLETION DATA:

(1) diameter (inches) 4

(2) total depth (feet) 168

(3) static water level (feet) 70 below above top of ground.

(4) casing PVC, 160,
 (material) (depth)
4 If telescope see back.
 (size)

(5) screen 8, 160
 (length) (depth to top)
4, PVC
 (size) (material)

(6) pump 1/2 19
 (HP) (yield gpm)
Electric
 (type power)

(7) electric log No
 (yes or no)
 (organization running log)

(8) how well bottom plugged hard plug

DRILLERS REMARKS:


DEPT. OF NATURAL RESOURCES
 BUREAU OF LAND & WATER RESOURCES

JAN 31 1980

RECEIVED

If well telescopes please sketch and show depths.

GROUND LEVEL

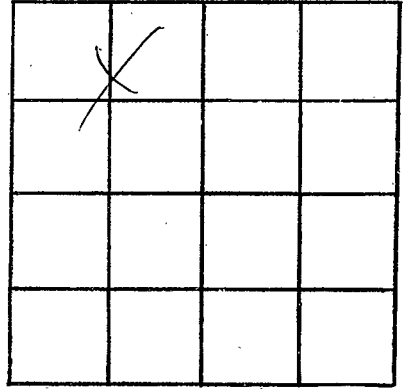

SECTION 2-1

Please indicate well location X.

ADDITIONAL INFORMATION

If more than one screen,
show locations of each on sketch.