

MISSISSIPPI DEPARTMENT OF NATURAL RESOURCES
 Bureau of Land and Water Resources
 Southport Mall
 P.O. Box 10631
 Jackson, Mississippi 39209
WATER WELL DRILLERS LOG

Walsh
8-20-83

8-9 1983 Fitzgerald & Co. Inc. Walsh
 date well completed firm name county well located

LANDOWNER:	description of formations encountered	from	to
<u>Ozela marks</u> <u>RR. Lytle town, ms.</u> (mailing address)			
WELL LOCATION:			
sec. <u>15</u> T. <u>1</u> N. R. <u>11</u> E. S. <u>5</u> W.			
<u>10</u> miles <u>SE</u> of <u>GLO</u> (distance) (direction) (nearest town)			
WELL PURPOSE: (home, irrigation, municipal, industrial)			
WELL COMPLETION DATA:			
(1) diameter (inches) <u>4</u>			
(2) total depth (feet) <u>132</u>			
(3) static water level (feet) <u>70</u> below above top of ground.			
(4) casing <u>pc</u> <u>124</u> (material) (depth) <u>4</u> if telescope see back. (size)			
(5) screen <u>8</u> <u>124</u> (length) (depth to top) <u>4</u> <u>pc</u> (size) (material)			
(6) pump <u>1/2</u> <u>10</u> (HP) (yield gpm) <u>Elc</u> (type power)			
(7) electric log <u>no</u> (yes or no) <u>Walsh</u> (organization running log)			
(8) how well bottom plugged <u>Walsh</u>			

DEPT. OF NATURAL RESOURCES
 BUREAU OF LAND & WATER RESOURCES


AUG 15 1983

RECEIVED

DRILLERS REMARKS:

If well telescopes please sketch and show depths.

GROUND LEVEL

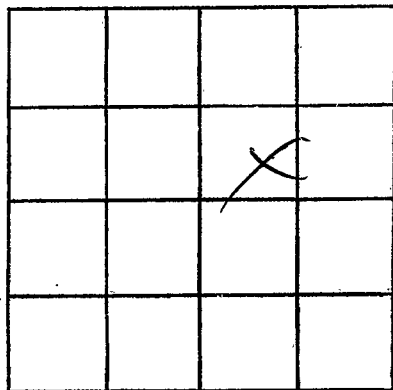

SECTION 15

Please indicate well location X.

ADDITIONAL INFORMATION

If more than one screen,
show locations of each on sketch.