

Walthall
 @ J
 2014

MISSISSIPPI
 BOARD OF WATER COMMISSIONERS
 416 North State Street
 Jackson, Mississippi 39201

WATER WELL DRILLERS LOG

1-31-84 19 Walthall firm name Walthall county well located

LANDOWNER: Mr. A. B. Conerly

description of formations encountered	from	to
<u>Clay Shale</u>	<u>0</u>	<u>10</u>
<u>Dry Gravel</u>	<u>10</u>	<u>25</u>
<u>Red Clay</u>	<u>25</u>	<u>40</u>
<u>Sand</u>	<u>40</u>	<u>86</u>

(mailing address)

WELL LOCATION:

sec. 3 T 1 N R 12 E
7 miles SE of Jaylinton
 (distance) (direction) (nearest town)

WELL PURPOSE: Home
 (home, irrigation, municipal, industrial)

WELL COMPLETION DATA:

- (1) diameter (inches) 4"
- (2) total depth (feet) 86
- (3) static water level (feet) 15 ^{below} _{above} top of ground.
- (4) casing Plastic 76
 (material) (depth)
4" if telescope see back.
 (size)
- (5) screen 104 76
 (length) (depth to top)
4" Plastic
 (size) (material)
- (6) pump 1/2 14
 (HP) (yield gpm)
Elect
 (type power)
- (7) electric log (yes or no) _____
- (8) how well bottom plugged BWV

DEPT. OF NATURAL RESOURCES
 BUREAU OF LAND & WATER RESOURCES

FEB - 3 1984


DRILLERS REMARKS:

RECEIVED

[Handwritten signature]

If well telescopes please sketch and show depths.

GROUND LEVEL

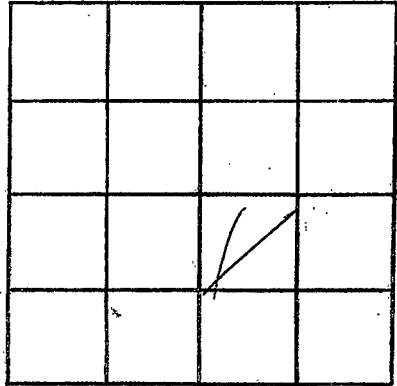

SECTION 3

Please indicate well location X.

ADDITIONAL INFORMATION

If more than one screen,
show locations of each on sketch.