

**MISSISSIPPI
BOARD OF WATER COMMISSIONERS
416 North State Street
Jackson, Mississippi 39201**

WATER WELL DRILLERS LOG

8 2015
 5/10/84 19 date well completed
 Shofford Well Ser. firm name
 Walthall county well located

LANDOWNER: Binky or Joe Neilson Jr.
 (mailing address)

WELL LOCATION:
 sec. 1 T. 1 N. R. 11 E. S. 5
4 miles South of Dyersburg
 (distance) (direction) (nearest town)

WELL PURPOSE:
 (home, irrigation, municipal, industrial)


- WELL COMPLETION DATA:
- (1) diameter (inches) 4"
 - (2) total depth (feet) 146
 - (3) static water level (feet) 80 below top of ground.
 - (4) casing plastic, 136,
 (material) (depth)
4"
 (size) if telescope see back.
 - (5) screen 10ft, 136
 (length) (depth to top)
4" plastic
 (size) (material)
 - (6) pump 1 (HP) 136 (yield gpm)
elect
 (type power)
 - (7) electric log _____
 (yes or no)
 - _____ (organization running log)
 - (8) how well bottom plugged Bar

description of formations encountered	from	to
top soil	0	2
red clay	2	70
dry gravel	70	100
chert	100	120
sand	120	146

DEPT. OF NATURAL RESOURCES
 BUREAU OF LAND & WATER RESOURCES


MAY 23 1984

RECEIVED

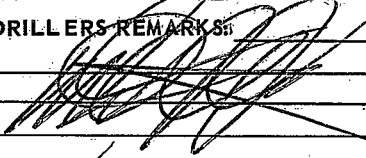DRILLERS REMARKS:


Periscopes please
sketch and show depths.

GROUND LEVEL

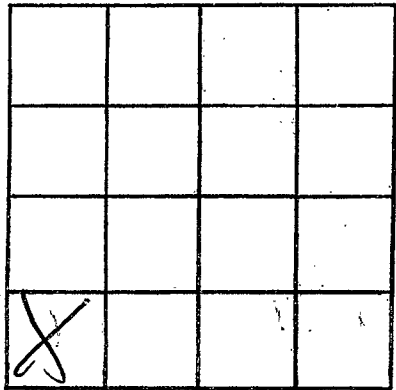

SECTION _____

Please indicate well location X.

ADDITIONAL INFORMATION

If more than one screen,
show locations of each on sketch.