

MISSISSIPPI DEPARTMENT OF NATURAL RESOURCES

Bureau of Land and Water Resources

Southport Mall

P.O. Box 10631

Jackson, Mississippi 39209

WATER WELL DRILLERS LOG

Walthall  
J 2007  
6-13-85

L

6-13 1985  
date well completed

Lyons Well Sew  
firm name

Walthall  
county well located

LANDOWNER:

Bill Watson

R.R. Lyubov M.  
(mailing address)

description of formations encountered

from

to

Red clay	0	20
Red sand	20	140
Coarse sand & gravel	140	158

WELL LOCATION:

sec. 34 T 1 N R 11 E  
8 miles <sup>S</sup> <sup>E</sup> of Lyubov  
(distance) (direction) (nearest town)

WELL PURPOSE:

Home  
(home, irrigation, municipal, industrial)

WELL COMPLETION DATA:

- (1) diameter (inches) 4
- (2) total depth (feet) 158
- (3) static water level (feet) 60 below above-top of ground.
- (4) casing PVC, 148  
(material) (depth)  
4 if telescope see back.  
(size)
- (5) screen 10, 148  
(length) (depth to top)  
4, PVC  
(size) (material)
- (6) pump 3/4, 15  
(HP) (yield gpm)  
Electric  
(type power)
- (7) electric log No  
(yes or no)  
Lyons Well Sew  
(organization running log)
- (8) how well bottom plugged Sealed

RECEIVED


JUL 29 1985

DRILLERS REMARKS:

Department of Natural Resources  
Bureau of Land & Water Resources

If well telescopes please sketch and show depths.

GROUND LEVEL

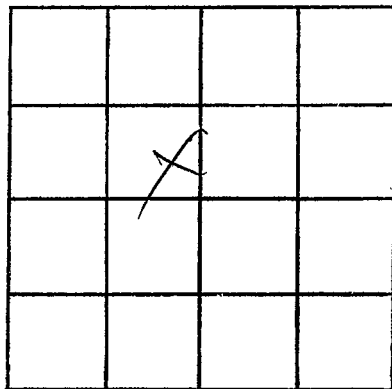

SECTION 24

Please indicate well location X.

ADDITIONAL INFORMATION

If more than one screen,  
show locations of each on sketch.