

WALTHAM
J 2018

MISSISSIPPI

BOARD OF WATER COMMISSIONERS

416 North State Street

Jackson, Mississippi 39201

WATER WELL DRILLERS LOG

3/11
date well completed

19 85 Red Martin & Son
firm name

WALTHAM
county well located

LANDOWNER: Daisy Ryals
Albert W. Ryals
Rt #7
Tylentown, Miss.
39667
(mailing address)

description of formations encountered

from to

Top clay 0 40
Fine sand 40 70
Chalk 70 95
Water Bearing sand 95 110

WELL LOCATION:

sec. 10 T 1 N R 11 E
S W
8 miles SE of Tylentown
(distance) (direction) (nearest town)
Miss.

WELL PURPOSE: Home
(home, irrigation, municipal, industrial)

WELL COMPLETION DATA:

- (1) diameter (inches) 4'
- (2) total depth (feet) 110'
- (3) static water level (feet) 80' below above top of ground.
- (4) casing pvc 110' (material) (depth)
(size) if telescope see back.
- (5) screen 10' 100' (length) (depth to top)
0.10-4" pvc (size) (material)
- (6) pump 1/2 hp 8 (HP) (yield gpm)
115 volt ac (type power)

(7) electric log (yes or no)
(organization running log)

(8) how well bottom plugged
2' sand subsoil


DRILLERS REMARKS:

RECEIVED
NOV 20 1995

Department of Natural Resources
Bureau of Land & Water Resources

If well telescopes please sketch and show depths.

GROUND LEVEL

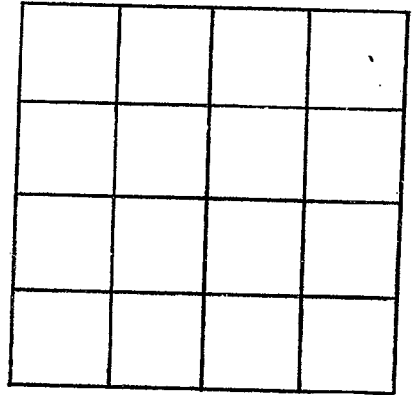

SECTION _____

Please indicate well location X.

ADDITIONAL INFORMATION

If more than one screen,
show locations of each on sketch.