

WALTHALL  
2008

MISSISSIPPI  
BOARD OF WATER COMMISSIONERS  
416 North State Street  
Jackson, Mississippi 39201

WATER WELL DRILLERS LOG

date well completed 19 08 firm name WALTHALL county well located

LANDOWNER: Charles Ray Polk  
& Cynthia A. Polk Rt 7  
Tylertown Ms 39667  
(mailing address)

description of formations encountered	from	to
<u>Top Clay</u>	<u>0</u>	<u>14'</u>
<u>Sand Pkgs</u>	<u>14'</u>	<u>146'</u>
<u>Dry sand</u>	<u>146'</u>	<u>60</u>
<u>Well Blocking Zone</u>	<u>60'</u>	<u>80'</u>

WELL LOCATION:  
sec. 24 T. 1 N. R. 11 E.  
Nine miles East of Tylertown  
(distance) (direction) (nearest town)

WELL PURPOSE: Home  
(home, irrigation, municipal, industrial)

- WELL COMPLETION DATA:
- (1) diameter (inches) 4"
  - (2) total depth (feet) 80'
  - (3) static water level (feet) 58' below above top of ground.
  - (4) casing PVC 80'  
(material) (depth)  
         if telescope see back.  
(size)
  - (5) screen 10x4" PVC 70'  
(length) (depth to top)  
0.10 PVC  
(size) (material)
  - (6) pump 1/2 8  
(HP) (yield gpm)  
120 volt ac  
(type power)
  - (7) electric log           
(yes or no)  
          
(organization running log)
  - (8) how well bottom plugged 2 1/2" sand & her valve


DRILLERS REMARKS:         

RECEIVED  
NOV 20 1985

Department of Natural Resources  
Bureau of Land & Water Resources

If well telescopes please sketch and show depths.

GROUND LEVEL

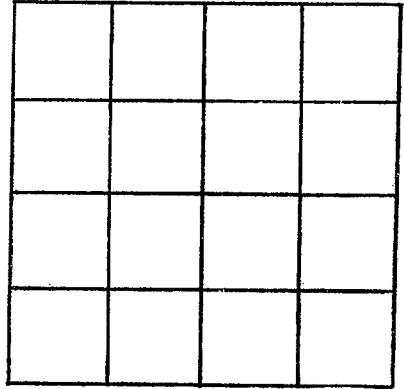

SECTION \_\_\_\_\_

Please indicate well location X.

ADDITIONAL INFORMATION

If more than one screen,  
show locations of each on sketch.