

W. J. ...
J. ...

MISSISSIPPI DEPARTMENT OF NATURAL RESOURCES
 Bureau of Land and Water Resources
 Southport Mall
 P.O. Box 10631
 Jackson, Mississippi 39209
 WATER WELL DRILLERS LOG

7-31-1990 Amite Pump & Well
 date well completed *Ruth C. Neal Secy* firm name county well located

LANDOWNER: Coley Fornea
 Rt 7 Box 265
 Tylertown, Ms. 39667
 (mailing address)

description of formations encountered	from	to
Clay	0	40
sand & Gr	40	120

WELL LOCATION:
 sec. 1 T N S R 11 E W
 miles ON BACK of (distance) (direction) (nearest town)

WELL PURPOSE: home
 (home, irrigation, municipal, industrial)

WELL COMPLETION DATA:
 (1) diameter (inches) 4
 (2) total depth (feet) 120
 (3) static water level (feet) 60 below above top of ground.
 (4) casing Sch 40 pvc ; 110'
 (material) (depth)
 _____ if telescope see back.
 (size)
 (5) screen 10 , 1200
 (length) (depth to top)
0.14 , sch. 40 pvc
 (size) (material)
 (6) pump 1 10
 (HP) (yield gpm)
220 elec.
 (type power)
 (7) electric log no
 (yes or no)

 (organization running log)

RECEIVED

AUG 24 1990

Department of Natural Resources
 Bureau of Land & Water Resources

(8) how well bottom plugged Back-
wash valve.

DRILLERS REMARKS:

If well telescopes please sketch and show depths.


GROUND LEVEL

SECTION _____

Please indicate well location X.

ADDITIONAL INFORMATION

From Warrenton 1st B. T. rd.
Right after cross over
Miss. line. 7 or 8 mi.
L at Calvery Baptist ch.
2nd driveway to L.

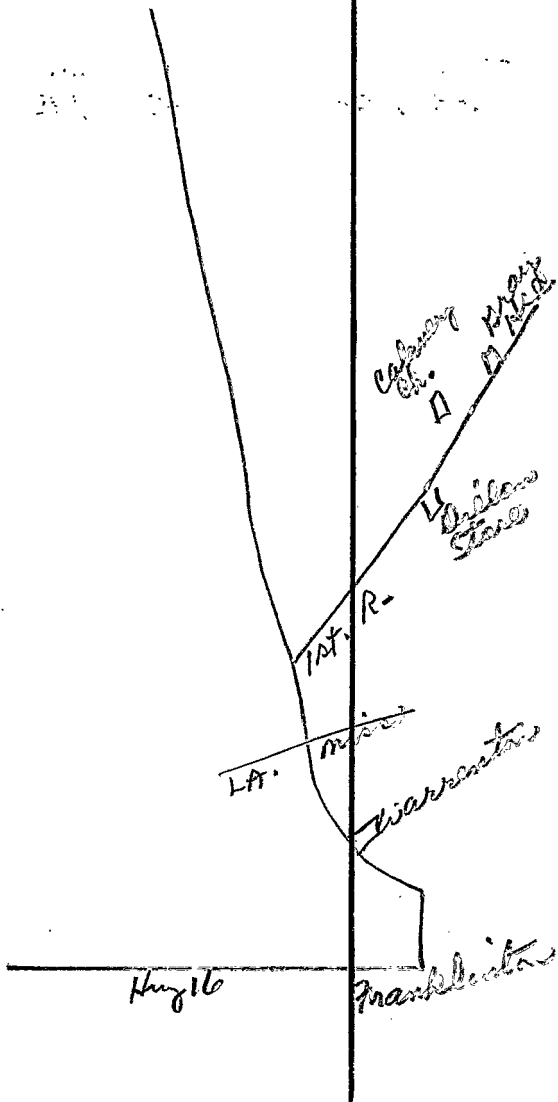

If more than one screen, show locations of each on sketch.