

# MISSISSIPPI DEPARTMENT OF NATURAL RESOURCES

Bureau of Land and Water Resources

P.O. Box 10631

Jackson, Mississippi 39209

WATER WELL DRILLERS LOG

COUNTY WELL LOCATED <i>Walsh</i>	
WELL NUMBER <i>J 2030</i>	CODED
DATE WELL COMPLETED <i>2-28-92</i>	

PERMIT NUMBER <i>287</i>
NAME OF DRILLING FIRM <i>Reeves Well Service</i>
<i>M. Comb</i>

NAME & MAILING ADDRESS OF LANDOWNER <i>Rock-R. Rainey</i> <i>Art. Tylertown</i>			
WELL LOCATION:	SEC <i>9</i>	TOWNSHIP <i>1</i>	RANGE <i>11</i>
DISTANCE <i>4</i> Miles	DIRECTION <i>E-SE</i>	NEAREST TOWN <i>Tylertown</i>	
OTHER LANDMARK <i>none</i>			
WELL PURPOSE (Home Irrigation, Municipal, Industrial, Fish Pond, etc.) <i>Trailer</i>			

PUMP DATA		
PUMP TYPE (Circle One): <u>Submersible</u> Turbine, Jet, Flowing Well, Other (Describe) _____		
POWER TYPE (Circle One): <u>Electric</u> Tractor, Diesel, Gasoline, Butane, Other (Describe) _____ H/P <i>3</i>		
Pump Capacity (GPM) <i>12</i>	No. of Stages <i>9</i>	Setting Depth <i>105'</i> FT.
PUMP TEST		
Well yielded <i>15</i> GPM with a drawdown of <i>none</i> ft. after <i>1/2</i> hours of pumping		

WELL DATA		
Well Depth <i>110</i>	Casing Diameter (In.) <i>4"</i>	Casing Length (Ft.) <i>100'</i>
Type of Casing <i>P.V.C</i>	Hole Depth <i>110'</i>	Depth to Static Water Level <i>82 ft</i>
TYPE OF COMPLETION: (Circle One or More): Gravel Packed, Underreamed, Telescoped, <u>Natural Development</u> , Open Hole, Other (Describe) _____		
Top of Lap Pipe or Reduction in Casing FEET <input type="checkbox"/> IF TELESKOPED OR MORE THAN ONE SCREEN: USE BACK PAGE		

LOG DATA	
TYPE OF LOG RUN (Circle One): <u>No Log Run</u> <del>Gamma Ray</del> , Density, Sonic, Neutron, Other (Describe) _____	
Name of Organization Running Log	

SCREEN DATA		
Diameter - Inches <i>4"</i>	Length - Feet <i>10'</i>	Slot Size - Inches <i>0.10</i>
Screen Type <i>P.V.C</i>	Depth to Bottom - Feet <i>110'</i>	

GEOLOGIC DATA (Office Use Only)			
Surface Elev.	Geologic Unit	Unit Thickness	Depth to Top
Subs. SWL	Date	Analysis	Aquifer Test

Driller's Remarks


DESCRIPTION OF FORMATIONS ENCOUNTERED	FROM	TO
<i>sandy clay</i>	<i>0</i>	<i>19</i>
<i>Red sand</i>	<i>19</i>	<i>40</i>
<i>pink clay &amp; sand</i>	<i>40</i>	<i>86</i>
<i>Coarse sand</i>	<i>86</i>	<i>110</i>
<i>3 spec. gravel</i>		

FORMATIONS (Continued)	FROM	TO
<div style="font-size: 2em; font-weight: bold; border: 2px solid black; padding: 5px; display: inline-block;">RECEIVED</div>		
<div style="font-size: 1.5em; font-weight: bold;">MAY 05 1992</div>		
<div style="font-weight: bold;">Dept. of Environmental Quality</div> <div style="font-weight: bold;">Bureau of Land &amp; Water Resources</div>		

IF MORE SPACE IS NEEDED, USE BACK

If well telescopes please  
sketch and show depths.

GROUND LEVEL

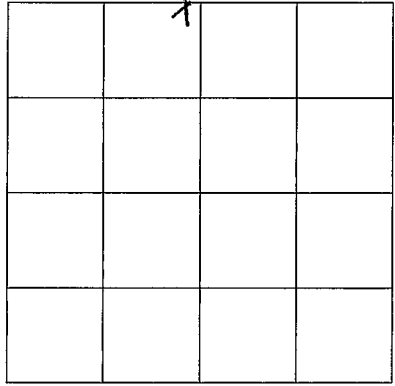

SECTION 0

Please indicate well location X.

ADDITIONAL INFORMATION

If more than one screen,  
show location of each on sketch.