

MISSISSIPPI DEPARTMENT OF ENVIRONMENTAL QUALITY
Bureau of Land and Water Resources

P. O. Box 10631
Jackson, MS 39289-0631
WATER WELL DRILLERS LOG

COUNTY WELL LOCATED <i>Walthall</i>	
WELL NUMBER <i>3</i>	CODED
DATE WELL COMPLETED <i>5/12/92</i>	

PERMIT NUMBER <i>0-508</i>
NAME OF DRILLING FIRM <i>Jordan Well Serv.</i>

NAME & MAILING ADDRESS OF LANDOWNER <i>Pat Dillon</i>			
<i>Hwy. 6, Box 198-A</i>			
<i>Sylvestown, Miss.</i>			
WELL LOCATION:	SEC	TOWNSHIP	RANGE
	<i>1</i>	<i>1</i>	<i>N 11 E</i>
DISTANCE	DIRECTION	NEAREST TOWN	
<i>10</i> Miles	<i>S</i>	<i>Sylvestown</i>	
OTHER LANDMARK			
WELL PURPOSE: <input checked="" type="radio"/> Home Irrigation, Municipal, Industrial, Fish Pond, etc.			

PUMP DATA			
PUMP TYPE (Circle One): <input checked="" type="radio"/> Submersible Turbine, Jet, Flowing Well, Other (Describe) _____			
POWER TYPE (Circle One): <input checked="" type="radio"/> Electric Tractor, Diesel, Gasoline, Butane, Other (Describe) _____ H/P _____			
Pump Capacity (GPM) <i>18</i>	No. of Stages <i>9</i>	Setting Depth <i>90</i> FT.	
PUMP TEST			
Well yielded _____ GPM with a drawdown of _____ ft. after _____ hours of pumping			

WELL DATA		
Well Depth <i>95</i>	Casing Diameter (In.) <i>4</i>	Casing Length (Ft.) <i>85</i>
Type of Casing <i>PVC</i>	Hole Depth <i>95</i>	Depth to Static Water Level <i>65</i>
TYPE OF COMPLETION: (Circle One or More): Gravel Packed, Underreamed, Telescoped, Natural Development, Open Hole, Other (Describe) <i>100% cement grout</i>		
Top of Lap Pipe or Reduction in Casing		
FEET		
IF TELESCOPED OR MORE THAN ONE SCREEN: USE BACK PAGE		

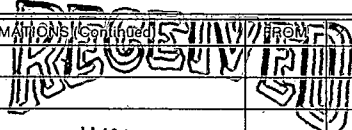
LOG DATA	
TYPE OF LOG RUN (Circle One): No Log Run, Electric, Gamma Ray, Density, Sonic, Neutron, Other (Describe) _____	
Name of Organization Running Log	

SCREEN DATA		
Diameter - Inches <i>4</i>	Length - Feet <i>10</i>	Slot Size - Inches <i>0.12</i>
Screen Type <i>PVC</i>	Depth to Bottom - Feet <i>85</i>	

GEOLOGIC DATA (Office Use Only)			
Surface Elev.	Geologic Unit	Unit Thickness	Depth to Top
Subs. SWL	Date	Analysis	Aquifer Test

Driller's Remarks

DESCRIPTION OF FORMATIONS ENCOUNTERED	FROM	TO
<i>top Soil</i>	<i>0</i>	<i>1</i>
<i>sandy clay</i>	<i>1</i>	<i>60</i>
<i>sand</i>	<i>60</i>	<i>95</i>

FORMATIONS (Continued)	FROM	TO
 JUN 01 1992 Dept. of Environmental Quality Bureau of Land & Water Resources		
IF MORE SPACE IS NEEDED, USE BACK		

If well telescopes please
sketch and show depths.

GROUND LEVEL

X			

SECTION 1

Please indicate well location X.

ADDITIONAL INFORMATION

If more than one screen,
show location of each on sketch.