

MISSISSIPPI DEPARTMENT OF ENVIRONMENTAL QUALITY
Bureau of Land and Water Resources

P. O. Box 10631
Jackson, MS 39289-0631
WATER WELL DRILLERS LOG

COUNTY WELL LOCATED Waltham		PERMIT NUMBER 0508
WELL NUMBER 2053	CODED	NAME OF DRILLING FIRM Jordan Well Ser.
DATE WELL COMPLETED 2/22/93		

NAME & MAILING ADDRESS OF LANDOWNER John Magee	
18 Ryals Rd.	
Tylertown, Ms. 39667	
WELL LOCATION: SEC	TOWNSHIP RANGE
1	1 N 11 W
DISTANCE 4 Miles	DIRECTION ESE of Tylertown
OTHER LANDMARK	
WELL PURPOSE: <input checked="" type="checkbox"/> Home Irrigation, <input type="checkbox"/> Municipal, <input type="checkbox"/> Industrial, <input type="checkbox"/> Fish Pond, etc.	

PUMP DATA		
PUMP TYPE (Circle One): Submersible, Turbine, Jet, Flowing Well, Other (Describe) _____		
POWER TYPE (Circle One): Electric, Tractor, Diesel, Gasoline, Butane, Other (Describe) _____ H/P _____		
Pump Capacity (GPM)	No. of Stages	Setting Depth FT.
PUMP TEST Well yielded _____ GPM with a drawdown of _____ ft. after _____ hours of pumping		

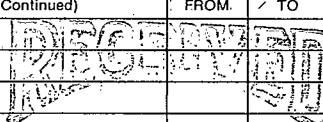
WELL DATA		
Well Depth 170	Casing Diameter (In.) 4	Casing Length (Ft.) 160
Type of Casing PVC	Hole Depth 170	Depth to Static Water Level 90
TYPE OF COMPLETION: (Circle One or More): Gravel Packed, Underreamed, Telescoped, Natural Development, Open Hole, Other (Describe) 10ft. Cement Grout		
Top of Lap Pipe or Reduction in Casing FEET <input type="checkbox"/> IF TELESCOPED OR MORE THAN ONE SCREEN: USE BACK PAGE		

LOG DATA	
TYPE OF LOG RUN (Circle One): Electric, Gamma Ray, Density, Sonic, Neutron, Other (Describe) _____ No Log Run, _____	
Name of Organization Running Log	

SCREEN DATA		
Diameter - Inches 4	Length - Feet 10	Slot Size - Inches .012
Screen Type PVC	Depth to Bottom - Feet 160	

GEOLOGIC DATA (Office Use Only)			
Surface Elev.	Geologic Unit	Unit Thickness	Depth to Top
Subs. SWL	Date	Analysis	Aquifer Test

Driller's Remarks

DESCRIPTION OF FORMATIONS ENCOUNTERED	FROM	TO	FORMATIONS (Continued)	FROM	TO
top soil	0	1	 FEB 23 1993 Dept. of Environmental Quality Office of Land & Water Resources		
sandy clay	1	45			
Dry Gravel	45	70			
Shale	70	90			
fine sand	90	140			
course sand	140	170			

IF MORE SPACE IS NEEDED, USE BACK

If well telescopes please
sketch and show depths.

GROUND LEVEL

X			

SECTION /

Please indicate well location X.

ADDITIONAL INFORMATION

If more than one screen,
show location of each on sketch.