

**MISSISSIPPI DEPARTMENT OF ENVIRONMENTAL QUALITY**  
Bureau of Land and Water Resources

P. O. Box 10631  
Jackson, MS 39289-0631  
**WATER WELL DRILLERS LOG**

COUNTY WELL LOCATED <b>WAITHAN</b>	
WELL NUMBER <b>2</b>	CODE #
DATE WELL COMPLETED <b>2034</b> <b>4/30/93</b>	

PERMIT NUMBER <b>0-508</b>
NAME OF DRILLING FIRM <b>Jordan Well Ser.</b>

NAME & MAILING ADDRESS OF LANDOWNER <b>Charles Sanders</b> <b>665 Kirkland Rd.</b> <b>Tylertown, Miss.</b>		
WELL LOCATION: SEC	TOWNSHIP	RANGE
<b>1</b>	<b>1</b>	<b>N</b>
		<b>W</b>
DISTANCE	DIRECTION	NEAREST TOWN
<b>6</b> Miles	<b>S</b>	of <b>tylertown</b>
OTHER LANDMARK		
WELL PURPOSE <input checked="" type="radio"/> Home Irrigation, Municipal, Industrial, Fish Pond, etc.		

<b>PUMP DATA</b>		
PUMP TYPE (Circle One): <input checked="" type="radio"/> Submersible, Turbine, Jet, Flowing Well, Other (Describe) _____		
POWER TYPE (Circle One): <input checked="" type="radio"/> Electric, Tractor, Diesel, Gasoline, Butane, Other (Describe) _____ H/P _____		
Pump Capacity (GPM) <b>10</b>	No. of Stages <b>8</b>	Setting Depth <b>50</b> FT.
PUMP TEST		
Well yielded _____ GPM with a drawdown of _____ ft. after _____ hours of pumping		

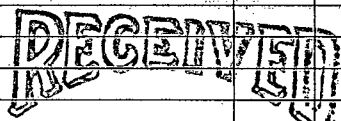
<b>WELL DATA</b>		
Well Depth <b>55</b>	Casing Diameter (in.) <b>4</b>	Casing Length (ft.) <b>45</b>
Type of Casing <b>PVC</b>	Hole Depth <b>55</b>	Depth to Static Water Level <b>30</b>
TYPE OF COMPLETION: (Circle One or More): Gravel Packed, Underreamed, Telescoped, Natural Development, Open Hole, Other (Describe) <b>10ft. cement grout</b>		
Top of Lap Pipe or Reduction in Casing		
FEET		
IF TELESCOPED OR MORE THAN ONE SCREEN: USE BACK PAGE		

<b>LOG DATA</b>	
TYPE OF LOG RUN (Circle One): <input type="radio"/> No Log Run, Electric, Gamma Ray, Density, Sonic, Neutron, Other (Describe) _____	
Name of Organization Running Log	

<b>SCREEN DATA</b>		
Diameter - Inches <b>4</b>	Length - Feet <b>10</b>	Slot Size - Inches <b>.012</b>
Screen Type <b>PVC</b>	Depth to Bottom - Feet <b>45</b>	

<b>GEOLOGIC DATA (Office Use Only)</b>			
Surface Elev.	Geologic Unit	Unit Thickness	Depth to Top
Subs. SWL	Date	Analysis	Aquifer Test

Driller's Remarks

DESCRIPTION OF FORMATIONS ENCOUNTERED	FROM	TO	FORMATIONS (Continued)	FROM	TO
<b>Top Soil</b>	<b>0</b>	<b>1</b>	 <b>MAY 10 1993</b> Dept. of Environmental Quality Office of Land & Water Resources		
<b>SANDY CLAY</b>	<b>1</b>	<b>35</b>			
<b>COURSE SAND</b>	<b>35</b>	<b>55</b>			

IF MORE SPACE IS NEEDED, USE BACK

If well telescopes please sketch and show depths.

GROUND LEVEL

X			

SECTION 1

Please indicate well location X.

ADDITIONAL INFORMATION

If more than one screen,  
show location of each on sketch.