

WALTHALL
J 2053

MISSISSIPPI
 BOARD OF WATER COMMISSIONERS
 416 North State Street
 Jackson, Mississippi 39201

WATER WELL DRILLERS LOG

03/15 1994 F. L. GERMANN Well Serv Walthall
 date well completed firm name county well located

LANDOWNER:
Mike Fortlanberry
RR. 1 plantation ms.
 (mailing address)

description of formations encountered	from	to
<u>Red Clay</u>	<u>0</u>	<u>23</u>
<u>Red Sand</u>	<u>20</u>	<u>156</u>
<u>Coarse sandstone</u>	<u>156</u>	<u>172</u>

WELL LOCATION:
 sec. 11 T. 1 N. R. 11 E
 S W
7 miles ESE of Plantation
 (distance) (direction) (nearest town)

WELL PURPOSE: part of house
 (home, irrigation, municipal, industrial)

WELL COMPLETION DATA:
 (1) diameter (inches) 4
 (2) total depth (feet) 172
 (3) static water level (feet) 78 below above top of ground.
 (4) casing PVC 162
 (material) (depth)
4 If telescope see back.
 (size)
 (5) screen 16 162
 (length) (depth to top)
4 PVC
 (size) (material)
 (6) pump 2 35
 (HP) (yield gpm)
El
 (type power)
 (7) electric log no
 (yes or no)
 (organization running log)
 (8) how well bottom plugged sealed

RECEIVED


JUN 17 1994

Dept. of Environmental Quality
 Office of Land & Water Resources

DRILLERS REMARKS:

If well telescopes please sketch and show depths.

GROUND LEVEL

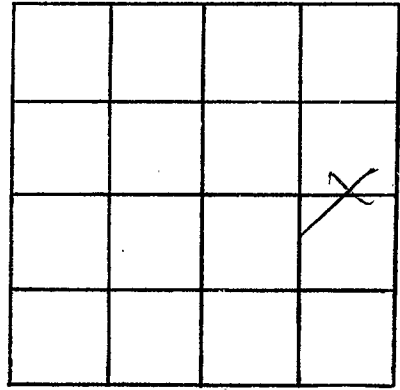

SECTION 11

Please indicate well location X.

ADDITIONAL INFORMATION

Lined area for additional information.

If more than one screen, show locations of each on sketch.