

Walthall
J 2044

MISSISSIPPI
BOARD OF WATER COMMISSIONERS
416 North State Street
Jackson, Mississippi 39201

WATER WELL DRILLERS LOG

APR 15 1994 E. F. BERARD Well Serv Walthall
date well completed firm name county well located

| LANDOWNER: | description of formations encountered | from | to |
|--|---------------------------------------|-----------|------------|
| <u>Johnny Holmes</u> | | | |
| <u>P.R. Lyntown ms.</u> (mailing address) | <u>Red Clay</u> | <u>0</u> | <u>23</u> |
| | <u>Red Sand</u> | <u>23</u> | <u>90</u> |
| | <u>Coarse Sandstone</u> | <u>90</u> | <u>121</u> |

WELL LOCATION:
sec. 4 T 1 N R 11 E
S W
3 miles SE of Lyntown
(distance) (direction) (nearest town)

WELL PURPOSE: DAIRY
(home, irrigation, municipal, industrial)

- WELL COMPLETION DATA:
- (1) diameter (inches) 4
 - (2) total depth (feet) 121
 - (3) static water level (feet) 21 below above
top of ground.
 - (4) casing PVC, 111,
(material) (depth)
4 if telescope see back.
(size)
 - (5) screen 10, 111
(length) (depth to top)
4, PVC
(size) (material)
 - (6) pump 2, 35
(HP) (yield gpm)
Electric
(type power)
 - (7) electric log no
(yes or no)
(organization running log)
 - (8) how well bottom plugged Sealed

RECEIVED


JUN 17 1994

Dept. of Environmental Quality
Office of Land & Water Resources

DRILLERS REMARKS:

If well telescopes please sketch and show depths.

GROUND LEVEL

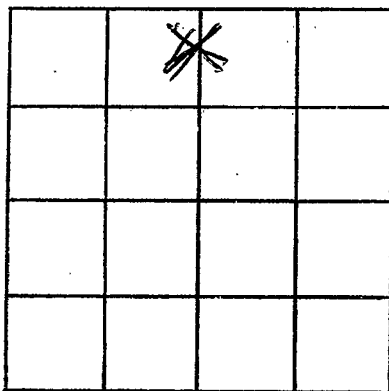

SECTION 4

Please indicate well location X.

ADDITIONAL INFORMATION

If more than one screen, show locations of each on sketch.