

**MISSISSIPPI DEPARTMENT OF ENVIRONMENTAL QUALITY**  
Bureau of Land and Water Resources

P. O. Box 10631  
Jackson, MS 39289-0631  
**WATER WELL DRILLERS LOG**

COUNTY WELL LOCATED <b>Waltham</b>	
WELL NUMBER <b>2</b>	CODED
DATE WELL COMPLETED <b>3/8/95</b>	

PERMIT NUMBER <b>0-508</b>
NAME OF DRILLING FIRM <b>Jordan Well Ser.</b>

NAME & MAILING ADDRESS OF LANDOWNER <b>Bill Hodges</b> <b>Tylertown, Miss.</b>			
WELL LOCATION: SEC	TOWNSHIP	RANGE	
<b>1</b>	<b>1</b>	<b>N</b>	<b>11 E</b>
DISTANCE <b>6</b> Miles		DIRECTION <b>S/E</b>	NEAREST TOWN <b>Tylertown</b>
OTHER LANDMARK			
WELL PURPOSE <input checked="" type="checkbox"/> Home Irrigation, Municipal, Industrial, Fish Pond, etc.			

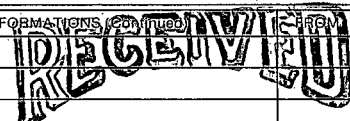
<b>PUMP DATA</b>		
PUMP TYPE (Circle One): <input checked="" type="radio"/> Submersible, <input type="radio"/> Turbine, <input type="radio"/> Jet, <input type="radio"/> Flowing Well, Other (Describe) _____		
POWER TYPE (Circle One): <input checked="" type="radio"/> Electric, <input type="radio"/> Tractor, <input type="radio"/> Diesel, <input type="radio"/> Gasoline, <input type="radio"/> Butane, Other (Describe) <b>1/2</b> H/P _____		
Pump Capacity (GPM) <b>10</b>	No. of Stages <b>8</b>	Setting Depth <b>110</b> FT.
PUMP TEST		
Well yielded _____ GPM with a drawdown of _____ ft. after _____ hours of pumping		

<b>WELL DATA</b>		
Well Depth <b>130</b>	Casing Diameter (In.) <b>4</b>	Casing Length (Ft.) <b>120</b>
Type of Casing <b>PVC</b>	Hole Depth <b>130</b>	Depth to Static Water Level <b>70</b>
TYPE OF COMPLETION: (Circle One or More): Gravel Packed, Underreamed, Telescoped, Natural Development, Open Hole, Other (Describe) <b>10ft. cement Grout</b>		
Top of Lap Pipe or Reduction in Casing		
FEET		
IF TELESCOPED OR MORE THAN ONE SCREEN: USE BACK PAGE		

<b>LOG DATA</b>	
TYPE OF LOG RUN (Circle One): <input type="radio"/> No Log Run, <input type="radio"/> Electric, <input type="radio"/> Gamma Ray, <input type="radio"/> Density, <input type="radio"/> Sonic, <input type="radio"/> Neutron, Other (Describe) _____	
Name of Organization Running Log	

<b>SCREEN DATA</b>		
Diameter - Inches <b>4</b>	Length - Feet <b>10</b>	Slot Size - Inches <b>1.012</b>
Screen Type <b>PVC</b>	Depth to Bottom - Feet <b>120</b>	

<b>GEOLOGIC DATA (Office Use Only)</b>			
Surface Elev.	Geologic Unit	Unit Thickness	Depth to Top
Subs. SWL	Date	Analysis	Aquifer Test

DESCRIPTION OF FORMATIONS ENCOUNTERED	FROM	TO	FORMATIONS (continued)	FROM	TO
<b>top soil</b>	<b>0</b>	<b>1</b>	 <b>APR 14 1995</b> Dept. of Environmental Quality Office of Land & Water Resources		
<b>Sandy Clay</b>	<b>1</b>	<b>35</b>			
<b>SHale</b>	<b>35</b>	<b>75</b>			
<b>SAND</b>	<b>75</b>	<b>130</b>			

IF MORE SPACE IS NEEDED, USE BACK

If well telescopes please  
sketch and show depths.

GROUND LEVEL

		X	

SECTION 1

Please indicate well location X.

ADDITIONAL INFORMATION

If more than one screen,  
show location of each on sketch.