

MISSISSIPPI DEPARTMENT OF ENVIRONMENTAL QUALITY

Office of Land and Water Resources

P. O. Box 10631
Jackson, MS 39289-0631
WATER WELL DRILLERS LOG

COUNTY WELL LOCATED
Waltham
WELL NUMBER
J
CODED
2059
DATE WELL COMPLETED
8/10/95

PERMIT NUMBER
0-508
NAME OF DRILLING FIRM
Jordan Well Ser.

NAME & MAILING ADDRESS OF LANDOWNER
DANNY LEA
tylertown, Miss.

WELL LOCATION: SEC TOWNSHIP RANGE
1 1 N 11 E

DISTANCE DIRECTION NEAREST TOWN
8 Miles SE of tylertown

OTHER LANDMARK

WELL PURPOSE: Home, Irrigation, Municipal, Industrial, Fish Pond, etc.

PUMP DATA

PUMP TYPE (Circle One):
Submersible Turbine, Jet, Flowing Well,
Other (Describe)

POWER TYPE (Circle One):
Electric Tractor, Diesel, Gasoline, Butane,
Other (Describe) **H/P**

Pump Capacity (GPM) No. of Stages Setting Depth
10 8 140 FT.

PUMP TEST
Well yielded _____ GPM with
a drawdown of _____ ft.
after _____ hours of pumping

WELL DATA

Well Depth Casing Diameter (In.) Casing Length (Ft.)
200 4" 190

Type of Casing Hole Depth Depth to Static Water Level
PVC 200 85

TYPE OF COMPLETION: (Circle One or More):
Gravel Packed, Underreamed, Telescoped,
Natural Development, Open Hole, Other
(Describe) **10ft. cement Grout**

WELL GROUTED TO A DEPTH OF **10 FEET**
Type Grout (circle one): **Cement** Bentonite, or Mix

LOG DATA

TYPE OF LOG RUN (Circle One):
No Log Run, Electric, Gamma Ray, Density, Sonic, Neutron,
Other (Describe)

Name of Organization Running Log

GEOLOGIC DATA (Office Use Only)

Surface Elev.	Geologic Unit	Unit Thickness	Depth to Top

Subs. SWL	Date	Analysis	Aquifer Test

SCREEN DATA

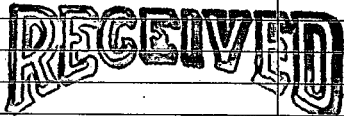
Diameter - Inches	Length - Feet	Slot Size - Inches
4	10	1012

Screen Type	Depth to Bottom - Feet
PVC	190

Driller's Remarks

Top of Lap Pipe or Reduction in Casing

FEET IF TELESCOPED OR MORE THAN ONE SCREEN: USE BACK PAGE

DESCRIPTION OF FORMATIONS ENCOUNTERED	FROM	TO	FORMATIONS (Continued)	FROM	TO
top soil	0	1	 AUG 23 1995 Dept. of Environmental Quality Office of Land & Water Resources		
SANDY CLAY	1	60			
SHALE	60	85			
SAND	85	105			
SHALE	105	170			
SAND	170	200			

IF MORE SPACE IS NEEDED, USE BACK

If well telescopes please
sketch and show depths.

GROUND LEVEL

SECTION _____

Please indicate well location X.

ADDITIONAL INFORMATION

If more than one screen,
show location of each on sketch.