

**MISSISSIPPI DEPARTMENT OF ENVIRONMENTAL  
QUALITY**  
Office of Land and Water Resources

P. O. Box 10631  
Jackson, MS 39289-0631  
**WATER WELL DRILLERS LOG**

COUNTY WELL LOCATED <u>Walthall</u>	
WELL NUMBER <u>J-2060</u>	CODED
DATE WELL COMPLETED <u>3-19-01</u>	

147

PERMIT NUMBER <u>0-621</u>
NAME OF DRILLING FIRM <u>Daniel Boone</u>

NAME & MAILING ADDRESS OF LANDOWNER <u>Mike Fortenberry</u>			
<u>Mt. Moriah Rd.</u>			
<u>Tylertown, MS</u>			
WELL LOCATION	SEC.	TOWNSHIP	RANGE.
	<u>11</u>	<u>1</u>	<u>11</u>
DISTANCE DIRECTION NEAREST TOWN. <u>6</u> Miles <u>SE</u> of <u>Tylertown</u>			
OTHER LANDMARK			
WELL PURPOSE: Home, Irrigation, Municipal, Industrial, Fish Pond, etc. <u>Chicken Farm</u>			

PUMP DATA		
PUMP TYPE (Circle One): <u>Submersible</u> Turbine, Jet, Flowing Well, Other (Describe)		
POWER TYPE (Circle One): <u>Electric</u> Tractor, Diesel, Gasoline, Butane, Other (Describe) H/P <u>2</u>		
Pump Capacity (GPM) <u>28</u>	No. of Stages	Setting Depth <u>140</u> FT.
PUMP TEST		
Well yielded <u>40</u> GPM with a drawdown of <u>35'</u> ft. after <u>12</u> hours of pumping		

WELL DATA		
Well Depth <u>175'</u>	Casing Diameter (In.) <u>4"</u>	Casing Length (Ft.) <u>155'</u>
Type of Casing <u>PVC</u>	Hole Depth <u>175</u>	Depth to Static Water Level <u>95'</u>
TYPE OF COMPLETION: (Circle One or More): <u>Gravel Packed</u> , Underreamed, Telescoped, Natural Development, Open Hole, Other (Describe)		
WELL GROUTED TO A DEPTH OF <u>10</u> FEET. Type Grout (circle one): <u>Cement</u> , Bentonite, or Mix		

LOG DATA	
TYPE OF LOG RUN (Circle One): <u>No Log Run</u> , Electric, Gamma-Ray, Density, Sonic, Neutron, Other (Describe)	
Name of Organization Running Log	


SCREEN DATA		
Diameter - Inches <u>4"</u>	Length - Feet <u>20'</u>	Slot Size - Inches <u>.008</u>
Screen Type <u>PVC Sch. 40</u>	Depth to Bottom - Feet <u>Ø</u>	

GEOLOGIC DATA (Office Use Only)			
Surface Elev.	Geologic Unit	Unit Thickness	Depth to Top
Subs. SWL	Date	Analysis	Aquifer Test
Driller's Remarks			
Top of Lap Pipe or Reduction in Casing			
FEET		IF TELESCOPED OR MORE THAN ONE SCREEN: USE BACK PAGE	

DESCRIPTION OF FORMATIONS ENCOUNTERED	FROM	TO	FORMATIONS (Continued)	FROM	TO
<u>Clay</u>	<u>0</u>	<u>14</u>	<u>1015 (C) 1017 (E) 1018 (U)</u>	<u>1015</u>	<u>1017</u>
<u>Sand &amp; Gravel</u>	<u>14</u>	<u>175</u>			
<u>MAR 23 2001</u>					
<u>Dept. of Environmental Quality</u> <u>Office of Land &amp; Water Resources</u>					
IF MORE SPACE IS NEEDED: USE BACK					

If well telescopes please sketch and show depths.


GROUND LEVEL

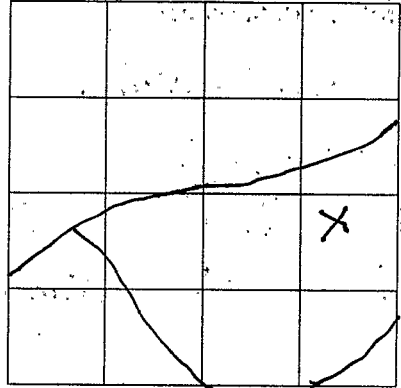

SECTION 11

Please indicate well location X.

ADDITIONAL INFORMATION

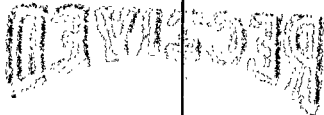

NOV 23 1960

U.S. GEOLOGICAL SURVEY  
WASHINGTON, D.C.

If more than one screen,  
show location of each on sketch.