

Walthall  
K 2  
6-9-67

MISSISSIPPI  
BOARD OF WATER COMMISSIONERS  
416 North State Street  
Jackson, Mississippi 39201

WATER WELL DRILLERS LOG

6-9 1967 Finner & Elbert Brown Walthall  
date well completed firm name county well located

LANDOWNER:

J. W. Pope  
Fylertown Miss  
(mailing address)

description of formations encountered

Red clay  
Sand & Gravel  
Pea Gravel

from to

0 25  
21 80  
80 98

WELL LOCATION:

sec. 7 T. 1 N. R. 12 E.  
S. W.  
6 miles S E of Fylertown  
(distance) (direction) (nearest town)


WELL PURPOSE:

Home  
(home, irrigation, municipal, industrial)

WELL COMPLETION DATA:

- (1) diameter (inches) 4"
- (2) total depth (feet) 98
- (3) static water level (feet) 80 below above top of ground.
- (4) casing Plastic, 93,  
(material) (depth)  
         if telescope see back.  
(size)
- (5) screen 4"-5",  
(length) (depth to top)  
        ,  
(size) (material)
- (6) pump 1 6  
(HP) (yield gpm)  
1/2 hp  
(type power)
- (7) electric log           
(yes or no)  
          
(organization running log)
- (8) how well bottom plugged WV


CODED

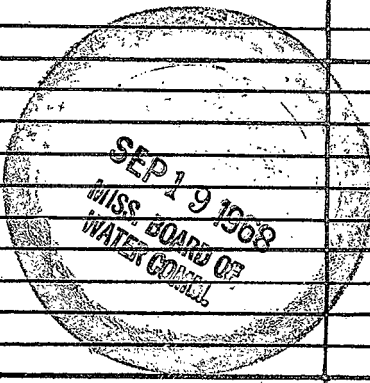

DRILLERS REMARKS:

If well telescopes please sketch and show depths.

GROUND LEVEL

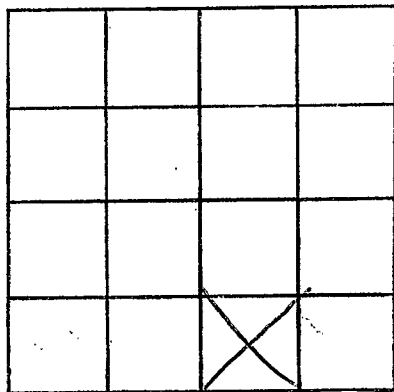

SECTION 7

Please indicate well location X.

ADDITIONAL INFORMATION

If more than one screen, show locations of each on sketch.